


CERTIFIED RECORD OF LAND CORNER MONUMENTATION

Index File No. P-3

History of original corner establishment:

None.

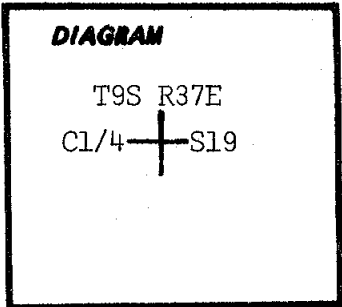

Description of corner evidence found:

Not set.

Description of monument and accessories established to perpetuate the original location of this corner:

At surveyed point set 2 1/2" x 30" galvanized pipe and brass cap marked: Set pipe 25" in the ground. No rock in the area.

From which by magnetic declination of N20°E: An 8" Pine bears N07°W, 56.6 ft. scribed C1/4S19 BT. A 6" Pine bears S35°E, 43.1 ft scribed C1/4S19 BT. Painted blazes red and 6" red band around. Placed 54-3s and brass washers stamped PLS 1051 on BTs. Placed 54-2 and 54-4 on steel fence post 5' South and 54-2 and 54-9 on steel fence post 5' West of the corner.

T9S R37E
C1/4 —+— S19
OR PLS 1051
1980

I hereby certify that the above corner monument was reestablished as herein described.

Witnesses: Daniel T. Rowland
Robert Boling

May 16, 1980

REGISTERED
PROFESSIONAL
LAND SURVEYOR

Barry B. Barbour
OREGON
OCT. 17, 1975
BARRY B. BARBOUR
1051

Office of... County Surveyor..... County of... Baker.....
State of... Oregon....., I hereby certify that the within instrument was filed in this office
for record on the...27... day of... June....., 1980
James D. Hawley by *Tom Hawley*
(COUNTY OFFICIAL) (DEPUTY)

Form R6-7100-57 (9/71)

FILED June 27, 1980
BAKER COUNTY SURVEYOR
SURVEY NO. 9-37-39

☆ GPO—798-278