


CERTIFIED RECORD OF LAND CORNER MONUMENTATION

Index File No. P-7

History of original corner establishment:

None

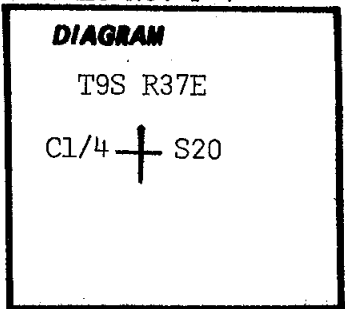

Description of corner evidence found:

Not Set.

Description of monument and accessories | established to perpetuate the original location of this corner:

At surveyed point set 2 1/2" X 30" galvanized pipe and brass cap marked: Set pipe 25" in the ground and mound of stone around to cap.

From which by magnetic declination of N20°E:

A 6" pine bears S70°E, 91.8 ft. scribed C1/4S20 BT.

A 5" pine bears S40°W, 16.1 ft. scribed C1/4S20 BT. Painted blazes red and 6" red band around. Placed 54-3s and brass washers stamped PLS 1051 on BTS.

Placed 54-2 on steel fence post 5' North, 54-2 and 54-4 on steel fence post 5' East, 54-2 on steel fence post 5' South and 54-2 and 54-9 on steel fence post 5' West of the corner.

T9S R37E

C1/4 + S20

OR PLS 1051  
1980

I hereby certify that the above corner monument was reestablished as herein described.

Witnesses: Daniel T. Rowland  
Harry Dunn

May 6, 1980

**REGISTERED  
PROFESSIONAL  
LAND SURVEYOR**

*Barry B. Barbour*

**OREGON  
OCT. 17, 1975  
BARRY B. BARBOUR  
1051**

Office of..... County Surveyor..... County of... Baker.....

State of..... Oregon....., I hereby certify that the within instrument was filed in this office for record on the... 27... day of... June... , 19... 80

..... James D. Hanley..... by..... Tom Hanley.....  
(COUNTY OFFICIAL) (DEPUTY)

Form R6-7100-57 (9/71)

June 27, 1980

FILED June 27, 1980

BAKER COUNTY SURVEYOR

SURVEY NO. 9-37-40