


**CERTIFIED RECORD OF LAND CORNER MONUMENTATION**

Index File No. Q-3

**History of original corner establishment:**

None.

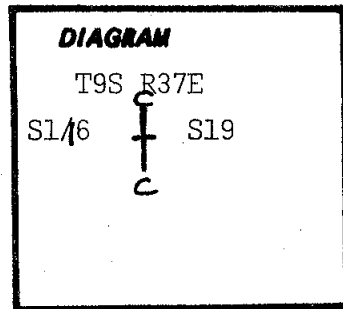


**Description of corner evidence found:**

Not Set.

**Description of monument and accessories established to perpetuate the original location of this corner:**

At surveyed point set 2 1/2" X 30" galvanized pipe and brass cap marked: Corner falls at North edge of 6" White Fir. Cut tree down. Set pipe 24" in the ground and mound of stone around to cap.

From which by magnetic declination of N20°E, A 12" tamarac bears N16°E, 23.6 ft. scribed CS1/16S19 BT. An 8" pine bears S02°W, 16.8 ft. scribed CS1/16S19 BT. Painted blazes red and 6" red band around. Placed 54-3s and Brass washers stamped PLS 1051 on BTs. Placed 54-2 and 54-4 on steel fence post 5' North and 54-2 and 54-9 on steel fence post 5' West of the corner.

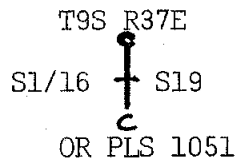

**REGISTERED  
PROFESSIONAL  
LAND SURVEYOR**

*Barry B. Barbour*

**OREGON  
OCT. 17, 1975  
BARRY B. BARBOUR  
1051**

I hereby certify that the above corner monument was reestablished as herein described.

Witnesses: Daniel T. Rowland  
Robert Boling

May 16, 1980

Office of...County..Surveyor..... County of... Baker.....  
State of... Oregon....., I hereby certify that the within instrument was filed in this office  
for record on the..27... day of... June....., 19..80  
..... James D. Hanley..... by ..... Tom Hanley.....  
(COUNTY OFFICIAL) (DEPUTY)

Form R6-7100-57 (9/71)

FILED June 27, 1980  
BAKER COUNTY SURVEYOR  
SURVEY NO. 2-37-42