


CERTIFIED RECORD OF LAND CORNER MONUMENTATION

Index File No. Q-7

History of original corner establishment:

None.

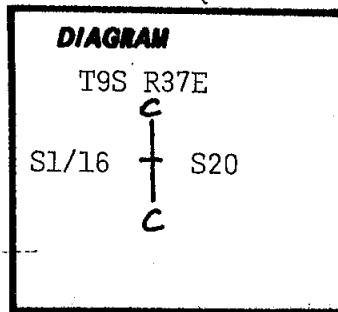

Description of corner evidence found:

Not Set.

Corner falls on the South side of an old ditch.

Description of monument and accessories established to perpetuate the original location of this corner:


At surveyed point set 2 1/2" X 30" galvanized pipe and brass cap marked; Set pipe 25" in the ground. No rock in the area.

From which by magnetic declination of N20°E:

A 9" pine bears N50°E, 42.8 ft. scribed CS1/16S20 BT.

A 13" tamarac bears S41°E, 53.6 ft. scribed CS1/16S20 BT.

A 5/8" X 24" rebar bears S74°E, 46.2 ft. Painted blazes red and 6" red band around. Placed 54-3s and brass washers stamped PLS 1051 on BTs. Placed 54-2 and 54-4 on steel fence post 5' North and 54-2 and 54-9 on steel fence post 5' East of the corner.

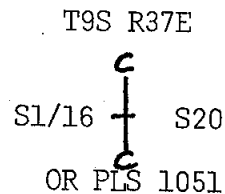

1980

**REGISTERED
PROFESSIONAL
LAND SURVEYOR**

Barry B. Barbour

OREGON
OCT. 17, 1975
BARRY B. BARBOUR
1051

I hereby certify that the above corner monument was reestablished as herein described.

Witnesses: Daniel T. Rowland
Harry Dunn

May 6, 1980

Office of... County Surveyor..... County of... Baker
Oregon
State of... Oregon....., I hereby certify that the within instrument was filed in this office
for record on the...27... day of... June....., 1980
James D. Hanley..... by..... Tom Hanley.....
(COUNTY OFFICIAL) (DEPUTY)

Form R6-7100-57 (9/71)

June 27, 1980

FILED June 27, 1980

BAKER COUNTY SURVEYOR

SURVEY NO. 9-37-44