


CERTIFIED RECORD OF LAND CORNER MONUMENTATION

Index File No. Q-8

History of original corner establishment:

None

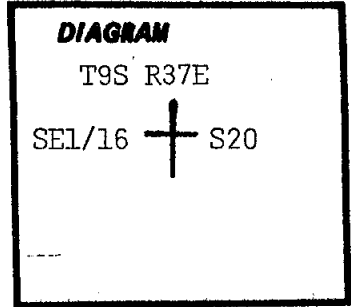

Description of corner evidence found:

Not Set.

Description of monument and accessories established to perpetuate the original location of this corner:

T9S R37E
SEL/16 + S20
OR PLS 1051
1980

At surveyed point set 2 1/2" X 30" galvanized pipe and brass cap marked: Set pipe 12" in the ground and mound of stone around to cap.

From which by magnetic declination of N 20°E:

A 6" fir bears N77°E, 50.5 ft. scribed SEL/16S20 BT. A 10" pine bears N49°W, 42.4 ft. scribed SEL/16S20 BT. Painted blazes red and 6" red band around. Placed 54-3s and brass washers stamped PLS 1051 on BTs. Placed 54-2 and 54-4 on steel fence post 5' North and 54-2 and 54-9 on steel fence post 5' West of the corner. Placed 54-2 on steel fence post 96' West on boundary.

I hereby certify that the above corner monument was reestablished as herein described.

Witnesses: Daniel T. Rowland
Tracy Hall

May 6, 1980

REGISTERED
PROFESSIONAL
LAND SURVEYOR

Barry B. Barbour
OREGON
OCT. 17, 1975
BARRY B. BARBOUR
1051

Office of..... County Surveyor..... County of..... Baker
State of..... Oregon..... I hereby certify that the within instrument was filed in this office
for record on the...27... day of.....June....., 1980.
.....James D. Hanley..... by.....Tom Hanley.....
(COUNTY OFFICIAL) (DEPUTY)

Form R6-7100-57 (9/71)

June 27, 1980

FILED June 27, 1980
BAKER COUNTY SURVEYOR
SURVEY NO. 9-37-45