


CERTIFIED RECORD OF LAND CORNER MONUMENTATION

Index File No. W-5

History of original corner establishment:

None.

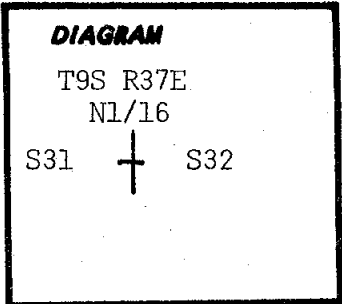

Description of corner evidence found:

Found L. Myers Cap on 5/8" rebar, flush with the ground. Two ft. South of the corner.

Corner is N45°W, 47 ft. from NW corner of small opening.

Description of monument and accessories established to perpetuate the original location of this corner:


At surveyed point set 2 1/2" X 30" galvanized pipe and brass cap marked: Set pipe 25" in the ground. No rock in the area.

From which by magnetic declination of N20°E:

A 7" Tamarac bears N54°E, 20.7 ft. scribed N1/16S32 BT.

An 8" Tamarac bears S35°W, 15.7 ft. scribed N1/16S31 BT.

Painted blazes red and 6" red band around. Placed 54-3s and brass washers stamped PLS 1051 on BTs. Placed 54-2 and 54-4 on steel fence post 5' North and placed 54-2 and 54-9 on steel fence post 5' East of the corner.

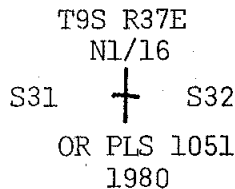

I hereby certify that the above corner monument was reestablished as herein described.

Witnesses: Daniel T. Rowland
Tracy Hall

April 16, 1980

**REGISTERED
PROFESSIONAL
LAND SURVEYOR**

Barry B. Barbour

**OREGON
OCT. 17, 1975
BARRY B. BARBOUR
1051**

Office of.. B.B. Barbour..... County of..... Baker
State of..... Oregon....., I hereby certify that the within instrument was filed in this office
for record on the...27... day of..... June....., 19.80
..... James D. Hanley..... by..... Tom Hanley.....
(COUNTY OFFICIAL) (DEPUTY)

Form R6-7100-57 (9/71)

FILED June 27, 1980

☆ GPO—798-278

BAKER COUNTY SURVEYOR

SURVEY NO. 9-37-48

June 27, 1980