


CERTIFIED RECORD OF LAND CORNER MONUMENTATION

Index File No. W-6

History of original corner establishment:

None.

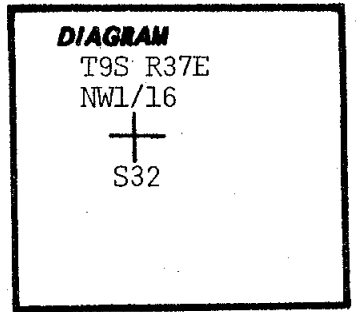

Description of corner evidence found:

Not Set.

Description of monument and accessories established to perpetuate the original location of this corner:

At surveyed point set 2 1/2" X 30" galvanized pipe and brass cap marked: Set pipe 22" in the ground to bedrock and mound of stone around to cap.

From which by magnetic declination of N20°E:

An 11" tamarac N07°E, 33.5 ft. scribed NW1/16S32 BT. A 10" tamarac bears S70°W, 53.0 ft. scribed NW1/16S32 BT. Painted blazes red and 6" red band around. Placed 54-3s and brass washers stamped PLS 1051 on BTs. Placed 54-2 and 54-4 and 54-9 on steel fence post 5' West of the corner.

T9S R37E  
NW1/16  
+  
S32  
OR PLS 1051  
1980

I hereby certify that the above corner monument was reestablished as herein described.

Witnesses: Daniel T. Rowland  
Tracy Hall

April 18, 1980

**REGISTERED  
PROFESSIONAL  
LAND SURVEYOR**

*Barry B. Barbour*

**OREGON  
OCT. 17, 1975  
BARRY B. BARBOUR  
1051**

Office of...County Surveyor..... County of...Baker.....

State of...Oregon....., I hereby certify that the within instrument was filed in this office

for record on the 27 day of June....., 1980

.....James D. Hanley..... by.....Tom Hanley.....  
(COUNTY OFFICIAL) (DEPUTY)

Form R6-7100-57 (9/71)

June 27, 1980

FILED June 27, 1980

BAKER COUNTY SURVEYOR

SURVEY NO. 9-37-49