


CERTIFIED RECORD OF LAND CORNER MONUMENTATION

Index File No. X-7

History of original corner establishment:

Corner was set by STS survey in 1899. A 3 1/2" X 3 1/2" X 36" post was used. The area has been completely dredged.

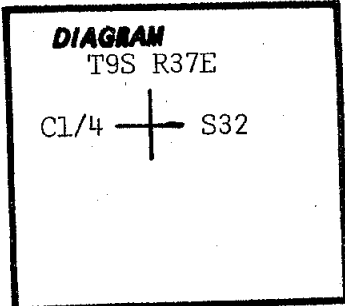


Description of corner evidence found:

At surveyed point corner falls at bottom of large tailing pile, about 3' East of dredge pond.

Description of monument and accessories I established to perpetuate the original location of this corner:

At surveyed point set 2 1/2" X 30" galvanized pipe and brass cap marked: Set pipe 20" in the ground and mound of stone around to cap. Due to Creek and ponds, no trees available within limits. Existing corner stamped:

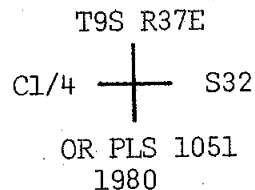

T9S R37E

Cl/4 S32

RPE 2808
1976

bears N31/2°W, 2.52 ft. Placed 54-4 on steel fence post 3' South of the corner.

**REGISTERED
PROFESSIONAL
LAND SURVEYOR**

Barry B. Barbour

OREGON
OCT. 17, 1975
BARRY B. BARBOUR
1051

I hereby certify that the above corner monument was reestablished as herein described.

Witnesses: Daniel T. Rowland
Robert Boling

May 27, 1980

Office of... County Surveyor... County of... Baker
State of... Oregon... I hereby certify that the within instrument was filed in this office
for record on the... 27... day of... June... 19... 80
James D. Hanley by... Tom Hanley
(COUNTY OFFICIAL) (DEPUTY)

Form R6-7100-57 (9/71)

June 27, 1980

FILED June 27, 1980

BAKER COUNTY SURVEYOR

SURVEY NO. 9-37-53