


CERTIFIED RECORD OF LAND CORNER MONUMENTATION

Index File No. Y-5

History of original corner establishment:

None.

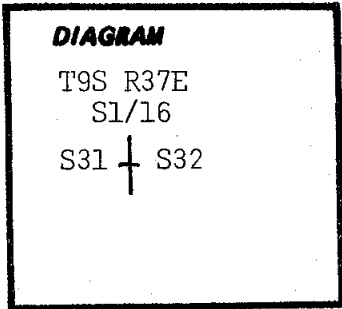

Description of corner evidence found:

Not Set.

Description of monument and accessories I established to perpetuate the original location of this corner:

At surveyed point set 2 1/2" X 30" galvanized pipe and brass cap marked: Set pipe 26" in the ground and mound of stone around to cap.

From which by magnetic declination of N20°E: A 14" pine bears N74°E, 25.2 ft. scribed S1/16S32 BT. An 8" pine bears S66°W, 62.0 ft. scribed S1/16S32 BT. Painted blazes red and 6" red band around. Placed 54-3s and brass washers stamped PLS 1051 on BTs Placed 54-2 and 54-4 on steel fence post 5' North and 54-2 and 54-9 on steel fence post 5' East of the corner.

T9S R37E
S1/16
S31 + S32
OR PLS 1051
1980

I hereby certify that the above corner monument was reestablished as herein described.

Witnesses: Daniel T. Rowland
Tracy Hall

April 16, 1980

**REGISTERED
PROFESSIONAL
LAND SURVEYOR**

Barry B. Barbour
**OREGON
OCT. 17, 1975
BARRY B. BARBOUR
1051**

Office of B.B. Barbour County of Baker
State of Oregon, I hereby certify that the within instrument was filed in this office
for record on the 27 day of June, 1980
James D. Hanley by Tom Hanley
(COUNTY OFFICIAL) (DEPUTY)

Form R6-7100-57 (9/71)

June 27, 1980

FILED June 27, 1980
BAKER COUNTY SURVEYOR
SURVEY NO. 9-37-55