


CERTIFIED RECORD OF LAND CORNER MONUMENTATION

Index File No. Z-6

History of original corner establishment:

None.

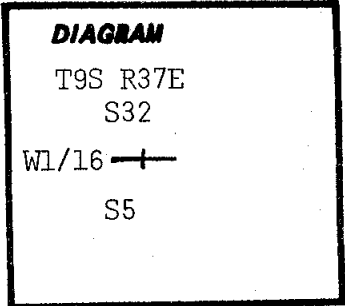

Description of corner evidence found:

Not Set.

Description of monument and accessories | established to perpetuate the original location of this corner:

At surveyed point set 2 1/2" X 30" galvanized pipe and brass cap marked: Set pipe 25" in the ground and mound of stone around to cap.

From which by magnetic declination of N20°E:

A 12" fir bears S08°W, 53.0 ft. scribed WL/16S5 BT.

An 8" fir bears N76°W, 15.0 ft. scribed WL/16S32 BT.

Painted blazes red and 6" red band around. Placed 54-3s and brass washers stamped PLS 1051 on BTs. Placed 54-2 and 54-9 on steel fence post 5' North and 54-2 on steel fence post 5' East of teh corner.

T9S R37E
S32
WL/16
S5
T10PSS
OR PLS 1051
1980

I hereby certify that the above corner monument was reestablished as herein described.

Witnesses: Daniel T. Rowland
Tracy Hall

April 17, 1980

**REGISTERED
PROFESSIONAL
LAND SURVEYOR**

Barry B. Barbour
**OREGON
OCT. 17, 1975
BARRY B. BARBOUR
1051**

Office of... County Surveyor... County of... ~~Grant~~ Baker
 State of... Oregon... I hereby certify that the within instrument was filed in this office
 for record on the... 27 day of... June... 19.80
James D. Henley by *Tom Hamley*
 (COUNTY OFFICIAL) (DEPUTY)

Form R6-7100-57 (9/71)

June 27, 1980

FILED June 27, 1980
 COUNTY NO. 9-37-57