


CERTIFIED RECORD OF LAND CORNER MONUMENTATION

Index File No. Z-7

History of original corner establishment:

Corner was established by E. McCormack under G.L.O. contract No. 39B, September 27, 1881. Surveyor General's notes state: " Set a basalt stone 14 X 12 X 9 ins. in the ground for 1/4 section corner marked 1/4 on North face and raised a mound of stone alongside."

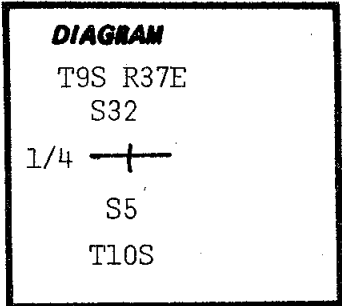


Description of corner evidence found:

Found no trace of corner stone. Found 4" X 4" X 30" rotten wood post set in ground with mound of stone around. Old glass insulator broken under mound. Two recently defaced BTs found to the NE and SW. STS notes show 3 1/2" X 3 1/2" X 36" wood posts used to mark corners. No other signs of a corner in the area.

Description of monument and accessories established to perpetuate the original location of this corner:

At the center of the above post, set 2 1/2" X 30" galvanized pipe and brass cap marked: Set pipe 18" in the ground and mound of stone around to cap. From which by magnetic declination of N20°E: A 7" fir bears N08°W, 30.0 ft. scribed 1/4S32 BT. A 9" fir bears S62°W, 83.1 ft scribed 1/4S5 BT. Painted blazes red and 6" red band around. Placed 54-3s and brass washers stamped PLS 1051 on BTs. Placed 54-2 and 54-4 on steel fence post 5' West and 54-2 on a steel fence post 5' South of the corner.

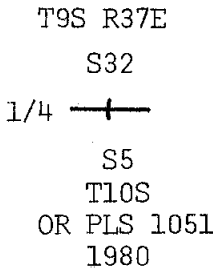

REGISTERED PROFESSIONAL LAND SURVFYOR

Barry B. Barbour
**OREGON
OCT. 17. 1975
BARRY B. BARBOUR
1051**

I hereby certify that the above corner monument was reestablished as herein described.

Witnesses: Daniel T. Rowland
Tracy Hall

April 16, 1980

Office of... County Surveyor... County of... ^{Grant} Baker
State of... Oregon... I hereby certify that the within instrument was filed in this office for record on the... 27... day of... June... 19.80
..... *James D. Hanley* by *Tom Hanley*
(COUNTY OFFICIAL) (DEPUTY)

Form R6-7100-51 (9/71)

June 27, 1980

FILED June 27, 1980
BAKER COUNTY SURVEYOR
SURVEY NO. 9-37-58