

CERTIFIED RECORD OF LAND CORNER MONUMENTATION


Index File No. Z-9

History of original corner establishment:

Corner was originally established by E. McCormack under G. L. O. contract No. 398, September 27, 1881. Surveyor General's notes state:

" Set post 4 ft. long, 4" square, 24" in the ground for corner to sections 4,5,32 and 33 marked T9S S33 on N.E., R37E S4 on S.E. T10S 55 on SW and S32 on NW faces with 4 notches on the East and 2 notches on the West edges.

From which: A Tamarac 24" in diameter bears N50°E, 65 lks. dist. marked T9SR37ES33 BT. An Alder 5" in diameter bears S50°E, 52 lks. dist. marked T10S R37E S4 BT. An Alder 5" in diameter bears S35°W, 13 lks. dist. marked T10S R37E S4 BT. An Alder 5" in diameter bears N65°W, 20 lks. dist. marked T9S R37E S32 BT."

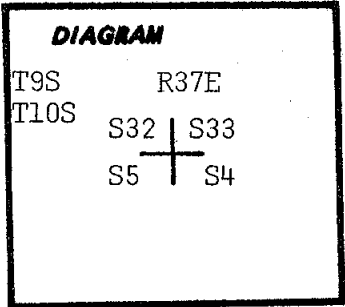

Description of corner evidence found:

The area the corner falls in has been dredged and no original evidence remains. Corner was reestablished by STS notes and plats from the 1/4 corner to sections 33 and 4 and the S1/16 corner of sections 32 and 33.


Corner falls near the top of tailings pile. Corner is about 700 ft. South of the Sumpter highway.

Description of monument and accessories established to perpetuate the original location of this corner:

At surveyed point set 2 1/2" X 30" galvanized pipe and brass cap marked: Set pipe in the gravel and mound of stone around to cap.

From which by magnetic declination of N20°E:

A 5" pine bears N17°E, 55.7 ft. scribed S33 BT. A 5" tamarac bears S37°E, 139.0 ft. scribed S4 BT. A 5" pine bears S57°W, 136.7 ft. scribed S5 BT. No suitable tree in NW quadrant. L. Myers 5/8" rebar bears S55 1/2°E, 10.2 ft. Painted blazes red and 6" red band around. Placed 54-3s and brass washers stamped PLS 1051 on BTs. Placed 54-4 on steel fence post 5' East of the corner.

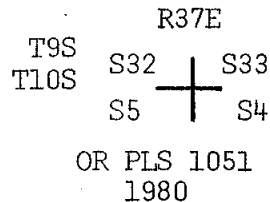

I hereby certify that the above corner monument was reestablished as herein described.

Witnesses: Daniel T. Rowland
Tracy Hall

April 22, 1980

**REGISTERED
PROFESSIONAL
LAND SURVEYOR**

Barry B. Barbour

**OREGON
OCT. 17, 1975
BARRY B. BARBOUR
1051**

Office of... County Surveyor..... County of... Baker

State of... Oregon....., I hereby certify that the within instrument was filed in this office
for record on the...27... day of... June....., 19..80

James D. Hamley..... by *Tom Hamley*.....
(COUNTY OFFICIAL) (DEPUTY)

Form R6-7100-57 (9/71)

June 27, 1980

FILED June 27, 1980

BAKER COUNTY SURVEYOR

SURVEY NO. 9-37-59