


CERTIFIED RECORD OF LAND CORNER MONUMENTATION

**History of original corner establishment:**

Original survey of mineral survey by William Hanley O.R.L.S. 1639 under contract No. 53 04HI-8-7079N for the U.S. Forest Service dated May 1979.

Angle point No. 1 is a 5/8" X 30" rebar set 24" in the ground. No accessories set.

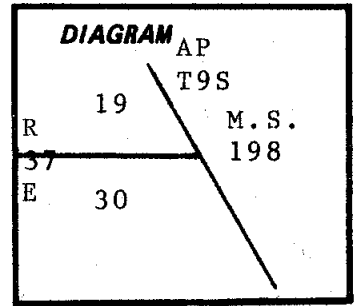

**Description of corner evidence found:**


At the Angle point location I found the rebar as set by William Hanley.

**Description of monument and accessories I established to perpetuate the original location of this corner:**

I replaced William Hanley's rebar with a 2½" X32" brass capped steel pipe set 24" in the ground from which:

- An 8" Lodgepole Pine bears S6°45'E 34.10ft. marked A P S30 BT Nail in E. base.
- An 8" Lodgepole Pine bears S82°30'W 32.52ft. marked X BT Nail in N. base.

Monument stamped:

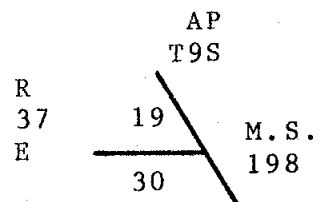

Bearings taken with a staff compass declination 18½° East per 1980 Isogonic chart.

Distances pulled to 60d nails with brass washers marked LS 1898 set in the side center of bearing trees.

1982  
O.R.L.S. 1898

REGISTERED  
PROFESSIONAL  
LAND SURVEYOR  
*Harry C. Hildebrand*  
OREGON  
JULY 13, 1980  
HARRY C. HILDEBRAND  
1898

7-19-82

Office of...Surveyor..... County of.....Baker.....  
State of.....Oregon....., I hereby certify that the within instrument was filed in this office  
for record on the..... day of....., 19.....

..... by .....  
(COUNTY OFFICIAL) (DEPUTY)

FILED July 19, 1982  
BAKER COUNTY SURVEYOR  
SURVEY NO. 9-37-74