


REPORT

**CORNER SEARCH, EVALUATION, MONUMENTING  
and  
BOUNDARY MARKING**

From \_\_\_\_\_ To \_\_\_\_\_

Region \_\_\_\_\_ Forest \_\_\_\_\_

*T* 9S *R.* 37E *WILLAMETTE* *Mer.*

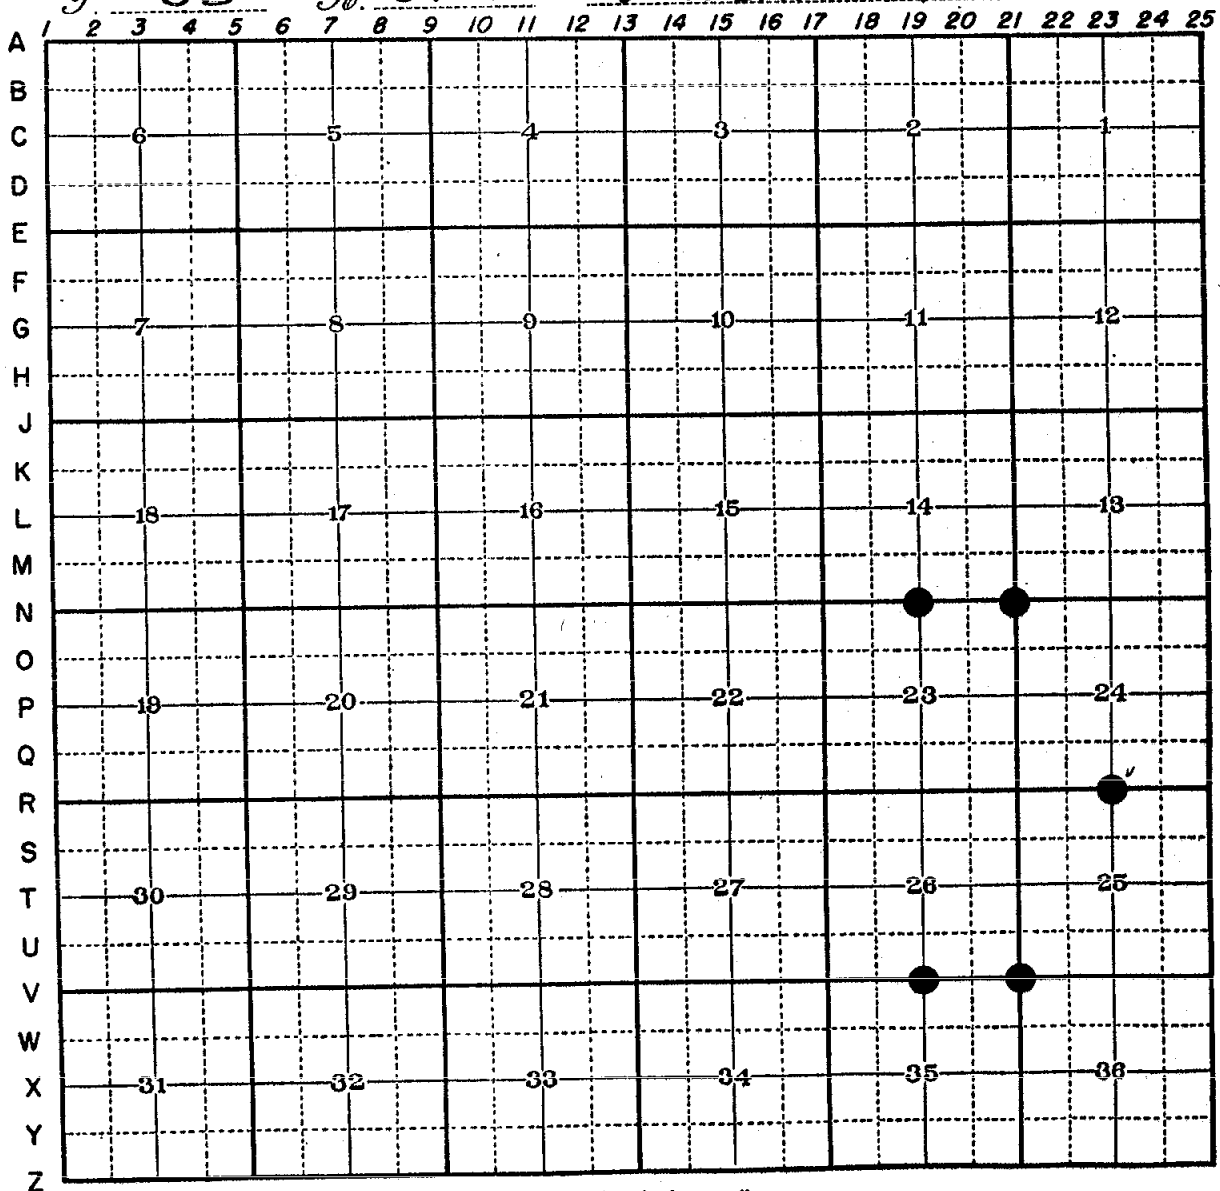

SCALE.—One inch = 1 mile.

**LEGEND**

- Corners searched for
- ⊗ Evidence believed acceptable
- Corners monumented
- Boundary posted (line only in red)