


CERTIFIED RECORD OF LAND CORNER MONUMENTATION

N-21

History of original corner establishment:

Corner established by William R. Gradon under GLO contract no. 416, dated August 19, 1881.

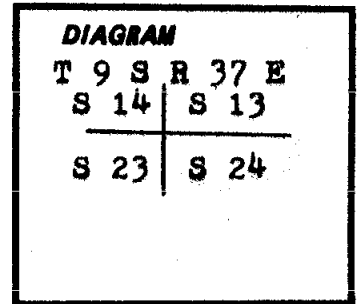

Surveyor General records state:

Set a basalt stone 16 x 10 x 7 ins 11 ins in the ground for cor to secs 13, 14, 23 & 24 marked with 3 notches on S and 1 notch on E edges; from which

- A pine 20 ins diam bears N 70° E, 95 lks dist marked T 9 S R 37 E S 13 BT
- A pine 24 ins diam bears S 15° E, 17 lks dist marked T 9 S R 37 E S 24 BT
- A pine 16 ins diam bears S 7° W, 30 lks dist marked T 9 S R 37 E S 23 BT
- A fire 24 ins diam bears N 60° W, 76 lks dist marked T 9 S R 37 E S 14 BT

Description of corner evidence found:

Section 24 bearing tree is a highout sawed stump with visible scribe marks.


Sec 14 and 23 bearing trees are sawed stumps with no visible scribes, lower blaze is evident on sec 14 BT.

No trace of section 13 bearing tree.

Description of monument and accessories I established to perpetuate the original location of this corner:

At the locus of distance intersections from the above described original accessory evidence set a 2½ inch aluminum cap on 2 inch aluminum pipe 31 inches long and projecting out of the ground 5 inches with a surrounding dirt and rock mound. Placed a 6 foot steel fence post alongside with a sign 54-9 attached.

Aluminum cap marked thus:

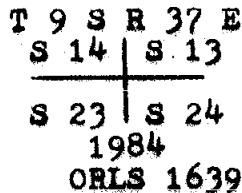

New bearing trees:

- A fir 6 ins diam bears N 14° E, 90.6 ft dist marked T 9 S R 37 E S 13 BT
- A fir 13 ins diam bears N 75° W, 94.1 ft dist marked T 9 S R 37 E S 14 BT
- A pine 8 ins diam bears S 46° W, 61.9 ft dist marked T 9 S R 37 E S 23 BT
- A fir 8 ins diam bears S 63° E, 39.5 ft dist marked T 9 S R 37 E S 24 BT

Each new bearing tree has a sign 54-3 attached below a 6 inch band of red paint and has a brass washer marked PLS 1639 nailed flush with BT blaze. A sign 54-9 is attached on the opposite side of tree from BT blaze. The original bearing tree stumps have a 6 inch band of red paint and signs 54-9 and 53-3 attached.

I hereby certify that the above described corner monument was properly established by me on Aug. 6, 1984 and witnessed by Jim DeMastus and Daryl Schuchardt.

Surveyor Baker County of Ore.
 Office of..... State of.....
 I hereby certify that the within instrument was filed in this office for record on the..... day of....., 19.....
 by..... (COUNTY OFFICIAL) (DEPUTY)

REGISTERED PROFESSIONAL LAND SURVEYOR

William L. Hanley

OREGON
 JULY 14, 1978
 WILLIAM L. HANLEY
 1639