


CERTIFIED RECORD OF LAND CORNER MONUMENTATION

R-23

History of original corner establishment:

Corner established by William R. Gradon under GLO contract no. 416 dated August 19, 1881.

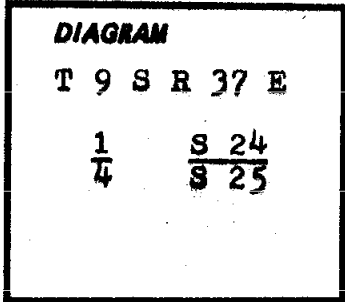

Surveyor General records state:

Set a post $3\frac{1}{2}$ ft long 3 ins square 24 ins in the ground for $\frac{1}{4}$ sec cor marked $\frac{1}{4}$ S on N face; from which:

- A pine 24 ins diam bears N 85° W, 30 lks dist marked $\frac{1}{4}$ S BT
- A pine 14 ins diam bears S 80° W, 39 lks dist marked $\frac{1}{4}$ S BT

Description of corner evidence found:


Section 24 bearing tree is a 28 inch diam live pine with partial scribe marks visible inside of 6 inches of overgrowth.

Section 25 bearing tree is a sawed stump with no visible scribe marks.

Description of monument and accessories established to perpetuate the original location of this corner:

At position established by distance intersection from the above described accessory evidence set a $2\frac{1}{2}$ inch aluminum cap on a 2 inch aluminum pipe 31 inches long and projecting 5 inches out of the ground with a surrounding dirt and rock mound and a 6 foot steel fence post 4 feet west of monument with a sign 54-9 attached.

Aluminum cap marked thus: T 9 S R 37 E

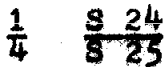

1984
ORLS 1639

New bearing trees and maintenance of original:

A pine 14 ins diam bears S 32° W, 3314 ft dist marked $\frac{1}{4}$ S 25 BT and has a brass washer marked PLS 1639 nailed flush with BT blaze. Both new and original bearing trees have a 6 inch band of red paint around and have signs 54-9 and 54-3 attached.

I hereby certify that the above described corner monument was properly established by me on July 28, 1984.

REGISTERED
PROFESSIONAL
LAND SURVEYOR

William L. Hanley

OREGON
JULY 14, 1978
WILLIAM L. HANLEY
1639

Office of.....Surveyor..... County of..... Baker
State of..... OREGON..... I hereby certify that the within instrument was filed in this office
for record on the..... day of....., 19.....

..... by
(COUNTY OFFICIAL) (DEPUTY)