


CERTIFIED RECORD OF LAND CORNER MONUMENTATION

V-19

History of original corner establishment:

Corner established by William R. Gradon under GLO contract no. 416 dated Aug. 19, 1881.

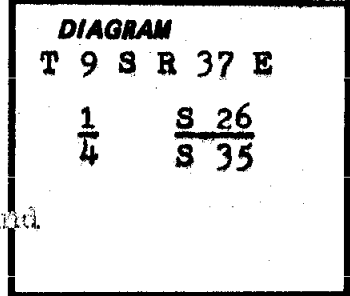

Surveyor General records state:

Set a post 3 1/2 ft long 3 ins square 24 ins in the ground for 1/4 sec cor marked 1/4 S on N face; from which:

- A pine 36 ins diam bears N 30°E, 71 lks dist marked 1/4 S BT
- A pine 36 ins diam bears S 3°E, 48 lks dist marked 1/4 S BT

Description of corner evidence found:

Section 35 bearing tree is a standing dead 36 inch snag with full scribes.

Section 26 bearing tree is a laid over sawed stump-no scribes visible on typical blaze.

Description of monument and accessories established to perpetuate the original location of this corner:

At position established from sec 35 original bearing tree set a 2 1/2 inch aluminum cap on a 2 inch aluminum pipe 31 inches long and projecting 6 inches out of the ground with a earth and stone mound around. Placed a 6 foot steel fence post alongside with a sign 54-9 attached.

Aluminum cap marked thus:

T 9 S R 37 E

$\frac{1}{4}$ $\frac{S 26}{S 35}$

1984
ORLS 1639

New bearing trees:

- A pine 7 inches diam bears N 50°W, 5.7 ft dist marked 1/4 S 26 BT
- A pine 7 inches diam bears S 18°E, 17.0 ft dist marked 1/4 S 35 BT

Each new bearing tree has a sign 54-3 attached below a 6 inch band of red paint and has a brass washer marked PLS 1639 nailed flush with BT blaze. A sign 54-9 is attached on the opposite side of tree from the BT blaze and a 6 foot steel fence post is placed alongside corner monument with a sign 54-9 attached. Each original accessory has signs 54-3 and 54-9 attached and has a 6 inch band of red paint around.

I hereby certify that the above described corner monument was established by me on August 8, 1984, and witnessed by Jim DeMastus and Daryl Schuchardt.

Office of.....Surveyor..... County of..... Baker.....
 State of.....Oregon..... I hereby certify that the within instrument was filed in this office
 for record on the..... day of....., 19.....
 by
 (COUNTY OFFICIAL) (DEPUTY)

REGISTERED
PROFESSIONAL
LAND SURVEYOR

William L. Hanley

OREGON
JULY 14, 1978
WILLIAM L. HANLEY
1639