

CERTIFIED RECORD OF LAND CORNER MONUMENTATION


History of original corner establishment:

Corner established by Wm. W. Elmer, U.S. Deputy Mineral Surveyor, under instructions received from the United States Surveyor General for Oregon dated Oct. 23, 1906, and designated as Survey No. 679.

Surveyor General records state:

A pine post 2 ft long 5 ins square set on bed rock with mound of stone scribed 3-679-AN-5-679-AGF.

A tamarack 14 ins dia bears S49°E 50.20 ft, a pine 10 ins dia bears S52°30'W 18.65 ft, both blazed and scribed 3-679-AN BT.

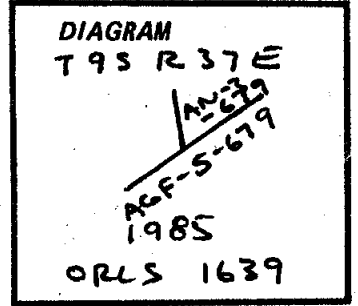

Description of corner evidence found:

Found 14 inch section of original post buried alongside.

A green tamarack 17 ins dia bears S49°E 50.20 ft with full scribes and 5 inch overgrowth.

Description of monument and accessories I established to perpetuate the original location of this corner:

Set a 2½" aluminum cap on 2" aluminum pipe 30 ins long 25 ins in ground with 5 ins proj. out of ground with surrounding rock mound and 6 ft steel fence post alongside with sign 54-9 attached. Buried remains of original post alongside.

Aluminum cap marked as shown in corner diagram.

New bearing tree established:

A fir 8 ins dia bears N30°30'W 5.7 ft marked AN3-AGF5-679 BT.

Each original bearing tree and each new bearing tree has signs 54-3 and 54-9 attached below a 6 in band of red paint, additionally each new bearing tree has a brass washer marked PLS 1639 nailed flush with BT blaze.

I hereby certify that the above described corner monument was properly established by me and witnessed by Jim DeMastus on April 25, 1985.

Witnessed: Jim DeMastus

REGISTERED
PROFESSIONAL
LAND SURVEYOR

William L. Hanley

OREGON
JULY 14, 1978
WILLIAM L. HANLEY
1639

Office of..... County Surveyor..... County of..... Baker.....
Oregon
State of..... I hereby certify that the within instrument was filed in this office
for record on the..... day of....., 19.....

..... by
(COUNTY OFFICIAL) (DEPUTY)

FILED March 14, 1986
BAKER COUNTY SURVEYOR
SURVEY NO. 9-37-88