

CERTIFIED RECORD OF LAND CORNER MONUMENTATION


History of original corner establishment:

Corner established by Wm. W. Elmer, U.S. Deputy Mineral Surveyor, under instructions received from the United States Surveyor General for Oregon dated Oct. 23, 1906, and designated as Survey No. 679.

Surveyor General records state:

Corner No. 4 located in the middle of road, no post set.

No bearing trees available.

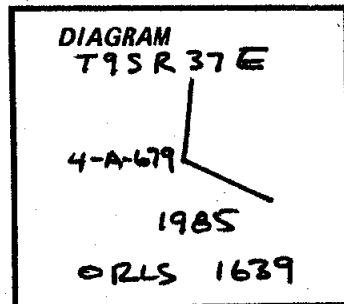

Description of corner evidence found:

No post set.

No bearing trees established.

Description of monument and accessories established to perpetuate the original location of this corner:

Set a 2½" aluminum cap on 2" aluminum pipe 30 ins long buried 6" below the road surface with a surrounding rock mound. Aluminum cap marked as shown in corner diagram.

New bearing trees established:

A fir 10 ins dia bears N81½°W 120.07 ft marked 4-A-679 BT.

A fir 16 ins dia bears S31°E 48.55 ft marked 4-A-679 BT.

Each new bearing tree has signs 54-3 and 54-9 attached below a 6 in band of red paint and brass washers marked PLS 1639 nailed flush with BT blaze.

I hereby certify that the above described corner monument was properly established by me and witnessed by Jim DeMastus and Daryl Schuchardt on May 20, 1985.

Witnessed: Jim DeMastus

REGISTERED
PROFESSIONAL
LAND SURVEYOR

William L. Hanley

OREGON
JULY 14, 1978
WILLIAM L. HANLEY
1639

Office of.....County Surveyor..... County of... Baker
State of.....Oregon....., I hereby certify that the within instrument was filed in this office
for record on the..... day of....., 19.....
..... by
(COUNTY OFFICIAL) (DEPUTY)

FILED March 14, 1986
BAKER COUNTY SURVEYOR
SURVEY NO. 9-37-93