

CERTIFIED RECORD OF LAND CORNER MONUMENTATION


History of original corner establishment:

Corner established by Wm. W. Elmer, U.S. Deputy Mineral Surveyor, under instructions received from the United States Surveyor General for Oregon dated Oct. 23, 1906, and designated as Survey No. 679.

Surveyor General records state:

A pine post 3½ ft long 5 ins square set 1½ ft in the ground with mound of earth and stone scribed 1-679-FC 2-679-AGF.

A pine 30 ins dia bears S60°30'E 44.40 ft, a pine 30 ins dia bears N03°30'W 23.65 ft, both blazed and scribed 1-679-FC BT.

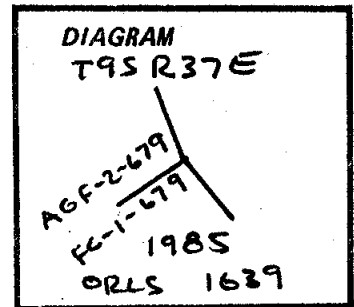

Description of corner evidence found:

No trace of original pine post.

A pine 36 ins dia bears S60°30'E 23.65 ft dist marked 1-679-FC BT(Record states S60°30'E 44.40 ft)

A pine 30 ins dia bears N03°30'W 44.40 ft dist marked 1-679-FC BT(record states N03°30'W 23.65 ft)

Description of monument and accessories | established to perpetuate the original location of this corner:

Set a 2½" aluminum cap on 2" aluminum pipe 30 ins long 25 ins in ground with 5 ins proj. out of ground with surrounding rock mound and 6 ft steel fence post alongside with sign 54-9 attached.

Aluminum cap marked as shown in corner diagram.

Each original bearing tree has signs 54-3 and 54-9 attached below a 6 inch band of red paint.

I hereby certify that the above described corner monument was properly established by me and witnessed by Jim DeMastus on April 25, 1985.

Witnessed: Jim DeMastus

**REGISTERED  
PROFESSIONAL  
LAND SURVEYOR**

*William L. Hanley*

**OREGON  
JULY 14, 1978  
WILLIAM L. HANLEY  
1639**

Office of.....County Surveyor..... County of..... Baker.....  
State of..... Oregon....., I hereby certify that the within instrument was filed in this office  
for record on the..... day of....., 19.....  
..... by .....

(COUNTY OFFICIAL)

(DEPUTY)

FILED March 14, 1986  
BAKER COUNTY SURVEYOR  
SURVEY NO. 9-37-95