

CERTIFIED RECORD OF LAND CORNER MONUMENTATION


History of original corner establishment:

Corner established by Wm. W. Elmer, U.S. Deputy Mineral Surveyor, under instructions received from the United States Surveyor General for Oregon dated Oct. 23, 1906, and designated as Survey No. 679.

Surveyor General records state:

A pine post 3 1/2 ft long 4 ins square set 1 1/2 ft in the ground with mound of earth and stone, scribed 4-679-AGF.

A pine 36 ins dia bears N80°40'E 21.40 ft, a fir 30 ins dia bears S72°38'W 20 ft, both blazed and scribed 4-679-AGF BT.

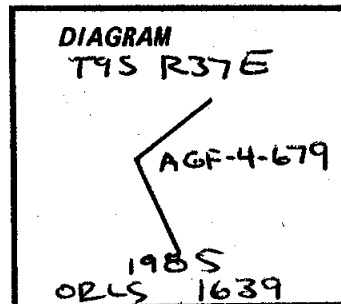

Description of corner evidence found:

No trace of original pine post.

A dead ponderosa pine 40 ins dia bears N80°E 21 ft with full scribes visible. A green douglas fir 36 ins dia bears S72°W 20 ft with full scribes visible.

Description of monument and accessories established to perpetuate the original location of this corner:

Set a 2 1/2" aluminum cap on 2" aluminum pipe 30 ins long 25 ins in ground with 5 ins proj. out of ground with surrounding rock mound and 6 ft steel fence post alongside with sign 54-9 attached.

Aluminum cap marked as shown in corner diagram.

New bearing tree established:

A pine 8 ins dia bears S37°30'E 25.8 ft marked AGF-4-679 BT.

Each original bearing tree and each new bearing tree has signs 54-3 and 54-9 attached below a 6 in band of red paint, additionally each new bearing tree has a brass washer marked PLS 1639 nailed flush with BT blaze.

I hereby certify that the above described corner monument was properly established by me and witnessed by Jim DeMastus on April 24, 1985.

Witnessed: Jim DeMastus

REGISTERED PROFESSIONAL LAND SURVEYOR

William L. Hanley

OREGON JULY 14, 1978 WILLIAM L. HANLEY 1639

Office of.....County Surveyor..... County of...Baker.....

State of.....Oregon..... I hereby certify that the within instrument was filed in this office for record on the..... day of....., 19.....

..... by (COUNTY OFFICIAL) (DEPUTY)

FILED March 14, 1986 BAKER COUNTY SURVEYOR SURVEY NO. 9-37-97