


CERTIFIED RECORD OF LAND CORNER MONUMENTATION

History of original corner establishment:

Corner established by Wm. W. Elmer, U.S. Deputy Mineral Surveyor, under instructions received from the United States Surveyor General for Oregon dated Oct. 23, 1906, and designated as Survey No. 679.

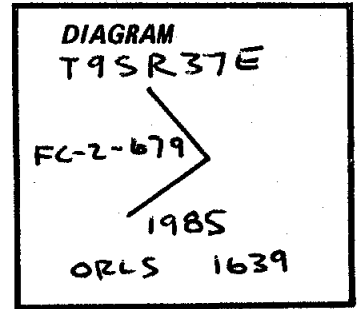

Surveyor General records state:

A pine post 3½ ft long 5 ins square set 1½ ft in the ground with a mound of earth, scribed 2-679-FC.

A pine 12 ins dia bears S67°20'E 14.60 ft, a pine 18 ins dia bears S25°20'E 30.30 ft, both blazed and scribed 2-679-FC BT.

Description of corner evidence found:

No trace of original pine post.

A pine 22 ins dia bears S87°20'E 30.30' (record states S67°20'E 14.60 ft) with healed blaze.

A sawed pine with tree alongside bears S25°20'E 14.60' (record states 30.30 ft) full scribes.

Description of monument and accessories | established to perpetuate the original location of this corner:

Set a 2½" aluminum cap on 2" aluminum pipe 30 ins long 25 ins in ground with 5 ins proj. out of ground with surrounding rock mound and 6 ft steel fence post alongside with sign 54-9 attached.

Aluminum cap marked as shown in corner diagram.

New bearing tree established:

A pine 8 ins dia bears S46°30'E 21.2 ft dist marked FC-2-679 BT.


Each original bearing tree and each new bearing tree has signs 54-3 and 54-9 attached below a 6 in band of red paint, additionally each new bearing tree has a brass washer marked PLS 1639 nailed flush with BT blaze.

I hereby certify that the above described corner monument was properly established by me and witnessed by Jim DeMastus on April 25, 1985.

Witnessed: Jim DeMastus



William L. Hanley

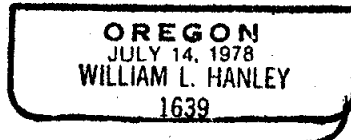

Office of.....County Surveyor..... County of..... Baker.....
State of..... Oregon....., I hereby certify that the within instrument was filed in this office
for record on the..... day of....., 19.....
..... by
(COUNTY OFFICIAL) (DEPUTY)

FILED March 14, 1986
BAKER COUNTY SURVEYOR
SURVEY NO. 9-37-98