

CERTIFIED RECORD OF LAND CORNER MONUMENTATION


History of original corner establishment:

Corner established by Wm. W. Elmer, U.S. Deputy Mineral Surveyor, under instructions received from the United States Surveyor General for Oregon dated Oct. 23, 1906, and designated as Survey No. 679.

Surveyor General records state:

A pine post 2½ ft long 5 ins square set on bedrock with mound of earth and stone, scribed 3-679-FC.

A fir 8 ins dia bears S01°27'W 27.40 ft, a fir 8 ins dia bears S54°20'W 67/55 ft. both blazed and scribed 3-679-FC BT.

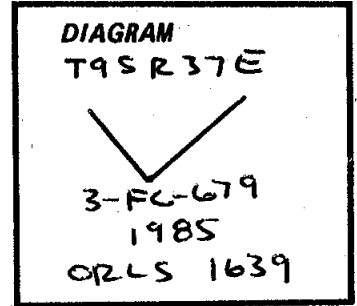

Description of corner evidence found:

No trace of original pine post.
No trace of original bearing trees.

Description of monument and accessories established to perpetuate the original location of this corner:

Set a 3 inch brass rock cap with concrete and rebar anchor.

New bearing trees established:

A fir 14 ins dia bears N41½°W 39.5 ft marked 3-FC-679 BT.
A fir 10 ins dia bears S08½°W 65.3 ft marked 3-FC-679 BT.

Each new bearing tree has signs 54-3 and 54-9 attached below a 6 inch band of red paint and a brass washer marked PLS 1639 nailed flush with BT blaze.

I hereby certify that the above described corner monument was properly established by me and witnessed by Jim DeMastus on May 20, 1985.

Witnessed: Jim DeMastus

**REGISTERED
PROFESSIONAL
LAND SURVEYOR**

William L. Hanley

**OREGON
JULY 14, 1978
WILLIAM L. HANLEY
1639**

Office of.....County Surveyor..... County of.....Baker.....
State of.....Oregon....., I hereby certify that the within instrument was filed in this office
for record on the..... day of....., 19.....
..... by
(COUNTY OFFICIAL) (DEPUTY)