

CERTIFIED RECORD OF LAND CORNER MONUMENTATION


History of original corner establishment:

Corner established by Wm. W. Elmer, U.S. Deputy Mineral Surveyor, under instructions received from the United States Surveyor General for Oregon dated Oct. 23, 1906, and designated as Survey No. 679.

Surveyor General records state:

A pine post 4 ft long 6 ins square set 1½ ft in the ground with mound of earth and stone, scribed 2-679-K.

A tamarack 10 ins dia bears S33°05'W 21.90 ft, a tamarack 10 ins dia bears N88°20'E 19.04 ft, both blazed and scribed 2-679-K BT.

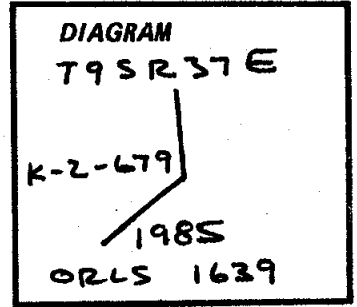

Description of corner evidence found:

Found remains of original pine post.

A tamarack stump with full scribes sawed off above scribes brs. S33°W, 21.9 ft.

A tamarack 14 ins dia with full scribes on an open blaze brs N88°20'E, 19.04 ft

Description of monument and accessories I established to perpetuate the original location of this corner:

Set a 2½" aluminum cap on 2" aluminum pipe 30 ins long 25 ins in ground with 5 ins proj. out of ground with surrounding rock mound and 6 ft steel fence post alongside with sign 54-9 attached. Buried remains of original post alongside.

Aluminum cap marked as shown in corner diagram.

New bearing tree established:

A pine 6 ins dia bears N15°E 24.6 ft marked K-2-679 BT.

Each original bearing tree and each new bearing tree has signs 54-3 and 54-9 attached below a 6 in band of red paint, additionally each new bearing tree has a brass washer marked PLS 1639 nailed flush with BT blaze.

I hereby certify that the above described corner monument was properly established by me and witnessed by Jim DeMastus and Daryl Schuchardt on April 30, 1985.

Witnessed: Jim DeMastus

**REGISTERED  
PROFESSIONAL  
LAND SURVEYOR**

*William L. Hanley*

**OREGON  
JULY 14, 1978  
WILLIAM L. HANLEY  
1639**

Office of.....County Surveyor..... County of..... Baker  
State of..... Oregon....., I hereby certify that the within instrument was filed in this office  
for record on the..... day of.....; 19.....  
..... by .....  
(COUNTY OFFICIAL) (DEPUTY)

FILED March 14, 1986  
BAKER COUNTY SURVEYOR  
SURVEY NO. 9-37-101