

CERTIFIED RECORD OF LAND CORNER MONUMENTATION


History of original corner establishment:

Corner established by Wm. W. Elmer, U.S. Deputy Mineral Surveyor, under instructions received from the United States Surveyor General for Oregon dated Oct. 23, 1906, and designated as Survey No. 679.

Surveyor General records state:

A pine post 3½ ft long 4 ins square set 1½ ft in the ground with a mound of earth and stone, scribed 3-679-K.

A fir 16 ins dia bears S71°W 37.66 ft, a pine 16 ins dia bears S60°20'W 39.15 ft, both blazed and scribed 3-679-K BT.

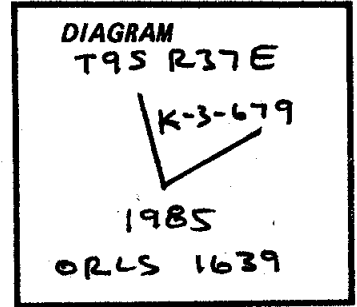

Description of corner evidence found:

No trace of original pine post.

A fir 27 ins dia bears S71°W 37.66 ft with full scribes.

Description of monument and accessories established to perpetuate the original location of this corner:

Set a 2½" aluminum cap on 2" aluminum pipe 30 ins long 25 ins in ground with 5 ins proj. out of ground with surrounding rock mound and 6 ft steel fence post alongside with sign 54-9 attached.

Aluminum cap marked as shown in corner diagram.

New bearing tree established:

A fir 18 ins dia bears S03°30'W 35.9 ft dist marked K-3-679 BT.

Each original bearing tree and each new bearing tree has signs 54-3 and 54-9 attached below a 6 in band of red paint, additionally each new bearing tree has a brass washer marked PLS 1639 nailed flush with BT blaze.

I hereby certify that the above described corner monument was properly established by me and witnessed by Jim DeMastus on April 24, 1985.

Witnessed: Jim DeMastus

**REGISTERED
PROFESSIONAL
LAND SURVEYOR**

William L. Hanley

**OREGON
JULY 14, 1978
WILLIAM L. HANLEY
1639**

Office of.....County..Surveyor..... County of.....Baker.....

State of.....OREGON....., I hereby certify that the within instrument was filed in this office for record on the..... day of....., 19.....

..... by

(COUNTY OFFICIAL)

(DEPUTY)

FILED March 14, 1986
BAKER COUNTY SURVEYOR
SURVEY NO. 9-37-102