


**CERTIFIED RECORD OF LAND CORNER MONUMENTATION**

**History of original corner establishment:**

Corner established by Arthur Philbrick, U.S. Deputy Mineral Surveyor, under instructions received from the United States Surveyor General for Oregon, dated Nov. 04, 1901, and designated as Survey No 452.

Surveyor General records state:

A pine post 4½ ft long 4 ins square set 2 ft in the ground with mound of earth, scribed BB 1-452 on NW face whence  
A tamarack 12 ins dia bears S41°39'E 10.8 ft and a red fir  
20 ins dia bears N31°21'E 7 ft each blazed and scribed BT BB 1-452.

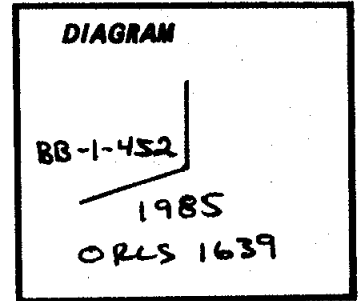

**Description of corner evidence found:**

Found a rotten post to a depth of 24 inches.  
A tamarack sawed stump 15 ins dia with no visible scribes, brs S41°39'E 10.8 ft.  
A rotten fir log with no visible scribes, N31°21'E 7 ft.

**Description of monument and accessories established to perpetuate the original location of this corner:**

Set a 2½ inch aluminum cap on a 2 inch aluminum pipe 30 ins long and buried 25 ins in the ground with 5 ins projecting out of the ground with a surrounding rock mound and a 6 ft steel fence post alongside with a sign 54-9 attached. Buried remains of original post.

Aluminum cap marked as shown in corner diagram.

New bearing tree established:

A fir 9 ins dia bears N84°30'E 24.5 ft marked BB-1-452 BT.  
A fir 11 ins dia bears N04°15'E 17.6 ft marked BB-1-452 BT.

Each new bearing tree has a brass washer marked PLS 1639 nailed flush with BT blaze and has signs 54-3 and 54-9 attached below a 6 inch band of red paint.

I hereby certify that the above described corner monument was properly established by me and witnessed by Jim DeMastus on April 23, 1985.

Witnessed: Jim DeMastus

REGISTERED  
PROFESSIONAL  
LAND SURVEYOR

*William L. Hanley*

OREGON  
JULY 14, 1978  
WILLIAM L. HANLEY  
1639

Office of.....County Surveyor..... County of...Baker.....  
State of.....Oregon..... I hereby certify that the within instrument was filed in this office  
for record on the..... day of....., 19.....  
..... by .....  
(COUNTY OFFICIAL) (DEPUTY)

FILED March 14, 1986  
BAKER COUNTY SURVEYOR  
SURVEY NO. 9-37-108