


CERTIFIED RECORD OF LAND CORNER MONUMENTATION

History of-original corner establishment:

Corner established by Arthur Philbrick, U.S. Deputy Mineral Surveyor, under instructions received from the United States Surveyor General for Oregon, dated Nov. 04, 1901, and designated as Survey No 452.

Surveyor General records state:

A fir post 4½ ft long 4 ins square set 2 ft in the ground with mound of earth, scribed BB 2-452 on N W face whence
A tamarack 12 ins dia bears S31°30'W 19.5 ft and a tamarack 18 ins dia bears N38°45'W 91 ft each blazed and scribed BT BB 2-452.

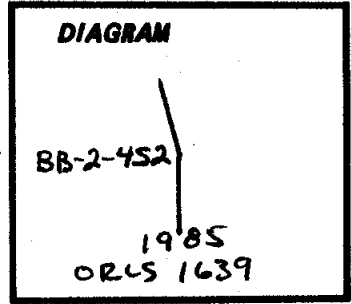

Description of corner evidence found:

Found a 14 in long section 5½"x5½" square post with fragmentary scribe marks.
A dead tamarack 12 ins dia with full scribes, brs S31°30'W 19.5 ft.
A green ponderosa pine 18 ins dia with healed blaze, brs N38°45'W 91 ft.

Description of monument and accessories established to perpetuate the original location of this corner:

Set a 2½ in aluminum cap on a 2 in aluminum pipe 30 ins long and buried 25 ins in the ground with 5 ins projecting out of the ground with a surrounding rock mound and a 6 ft steel fence post alongside with a sign 54-9 attached. Buried remains of original post. Aluminum cap marked as shown in corner diagram.

New bearing tree established:

A lodgepole pine 6 ins dia bears N33°30'E 11.2 ft marked BB2-452 BT.

Each new bearing tree has a brass washer marked PLS 1639 nailed flush with BT blaze and has signs 54-3 and 54-9 attached below a 6 inch band of red paint.

I hereby certify that the above described corner monument was properly established by me and witnessed by Jim DeMastus on April 23, 1985.

Witnessed: Jim DeMastus

REGISTERED
PROFESSIONAL
LAND SURVEYOR

William L. Hanley

OREGON
JULY 14, 1978
WILLIAM L. HANLEY
1639

Office of..... County Surveyor..... County of... Baker
Oregon
State of....., I hereby certify that the within instrument was filed in this office
for record on the..... day of....., 19.....
..... by
(COUNTY OFFICIAL) (DEPUTY)

FILED March 14, 1986
BAKER COUNTY SURVEYOR
SURVEY NO. 9-37-109