

CERTIFIED RECORD OF LAND CORNER MONUMENTATION


History of original corner establishment:

Corner established by Arthur Philbrick, U.S. Deputy Mineral Surveyor, under instructions received from the United States Surveyor General for Oregon, dated Nov. 04, 1901, and designated as Survey No 452.

Surveyor General records state:

A black pine 6 ins dia bears S34°30'E 20 ft, and a tamarack 12 ins dia bears S79°54'E 28.6 ft each blazed and scribed BT BB 3-452.

A pine post 4½ ft long 4 ins square set 2 ft in the ground with mound of earth scribed BB 3-452 on SW face.

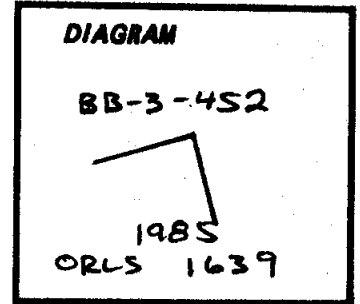

Description of corner evidence found:

Found a rock mound.

A green ponderosa pine (notes say black pine) 19 ins dia with healed blaze, brs S34°30'E 20 ft. No trace of the other bearing tree.

Description of monument and accessories established to perpetuate the original location of this corner:

Set 2½ in aluminum cap on 2 in aluminum pipe 30 ins long 25 ins in ground with 5 ins proj. out of ground with rock mound and 6 ft steel fence post alongside with sign 54-9 attached.

Aluminum cap marked as shown in corner diagram.

New bearing tree established:

A fir 8 ins dia bears N49°30'W 11.7 ft marked BB3-452 BT.

Each original bearing tree and each new bearing tree has signs 54-3 and 54-9 attached below a 6 inch band of red paint, additionally each new bearing tree has a brass washer marked PLS 1639 nailed flush with BT blaze.

I hereby certify that the above described corner monument was properly established by me and witnessed by Jim DeMastus on April 23, 1985.

Witnessed: Jim DeMastus

REGISTERED
PROFESSIONAL
LAND SURVEYOR

William L. Hanley

OREGON
JULY 14, 1978
WILLIAM L. HANLEY
1639

Office of.....County Surveyor..... County of...Baker.....
State of.....Oregon....., I hereby certify that the within instrument was filed in this office
for record on the..... day of....., 19.....

..... by

(COUNTY OFFICIAL)

(DEPUTY)

FILED March 14, 1986
BAKER COUNTY SURVEYOR
SURVEY NO. 9-37-110