


CERTIFIED RECORD OF LAND CORNER MONUMENTATION

History of original corner establishment:

Corner established by Arthur Philbrick, U.S. Deputy Mineral Surveyor, under instructions received from the United States Surveyor General for Oregon, dated Nov.04, 1901 and designated as Survey No 452.

Surveyor General records state:

A tamarack post 4½ ft long 4 ins square set 2 ft in the ground with mound of earth scribed BB 5-452 on NE face whence
A tamarack 12 ins in diam bears N58°W 31.4 ft and a red fir
24 ins in diam bears S41°W 6.6 ft each blazed and scribed BT BB 5-452.

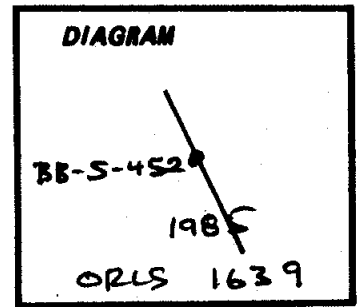

Description of corner evidence found:

No trace of rock mound or of original post.

A fir snag 44 ins dia broken at 15' with full scribes on open blaze, brs S41°W 6.6 ft. No trace of the other BT.

Description of monument and accessories established to perpetuate the original location of this corner:

Set 2½ in aluminum cap on 2 in aluminum pipe 30 ins long 25 ins in ground with 5 ins proj. out of ground with rock mound and 6 ft steel fence post alongside with sign 54-9 attached.

Aluminum cap marked as shown in corner diagram.

New bearing trees established:

A fir 12 ins dia bears S86°30'W 9.1 ft marked BB5-452 BT.
A fir 9 ins dia bears N31°45'W 25.7 ft marked BB5-452 BT.

Each original bearing tree and each new bearing tree has signs 54-3 and 54-9 attached below a 6 in band of red paint, additionally each new bearing tree has a brass washer marked PLS 1639 nailed flush with BT blaze.

I hereby certify that the above described corner monument was properly established by me and witnessed by Jim DeMastus on April 23, 1985.

Witnessed: Jim DeMastus

REGISTERED
PROFESSIONAL
LAND SURVEYOR

William L. Hanley

OREGON
JULY 14, 1978
WILLIAM L. HANLEY
1639

Office of...County...Surveyor..... County of...Baker.....

State of...Oregon....., I hereby certify that the within instrument was filed in this office

for record on the..... day of....., 19.....

..... by

(COUNTY OFFICIAL)

(DEPUTY)

FILED March 14, 1986

BAKER COUNTY SURVEYOR

SURVEY NO. 9-37-112