


CERTIFIED RECORD OF LAND CORNER MONUMENTATION

**History of original corner establishment:**

Corner established by Arthur Philbrick, U.S. Deputy Mineral Surveyor, under instructions received from the United States Surveyor General for Oregon, dated Nov.04, 1901 and designated as Survey No 452.

Surveyor General records state:

A pine post 4½ ft long 4 ins square set 2 ft in the ground with mound of earth, scribed BB 6-452 on NE face whence a tamarack 20 ins in diam bears S87°30'W 19.1 ft and a red fir 24 ins in diam bears S9°30'E 7 ft each blazed and scribed BT BB 6-452.

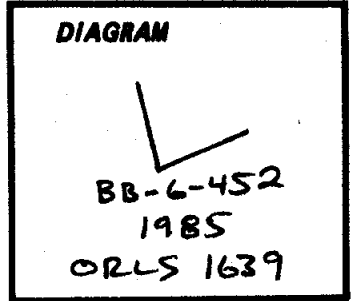

**Description of corner evidence found:**

Found location post a 10 in dia dead tree blazed on four sides.

A green fir 34 ins dia marked "6-452" visible in a partially healed blaze, brs S9°30'E 7 ft. A down tamarack 16 ins dia with full scribes visible, brs S87°30'W 19.1 ft dist.

**Description of monument and accessories I established to perpetuate the original location of this corner:**

Set 2½ in aluminum cap on 2 in aluminum pipe 30 ins long 25 ins in ground with 5 ins proj. out of ground with rock mound and 6 ft steel fence post alongside with sign 54-9 attached. Buried remains of original post alongside.

Aluminum cap marked as shown in corner diagram.

New bearing tree established:

A fir 16 ins dia bears N80°30'E 42,5 ft marked BB6-452 BT.

Each original bearing tree and each new bearing tree has signs 54-3 and 54-9 attached below a 6 in band of red paint, additionally each new bearing tree has a brass washer marked PLS 1639 nailed flush with BT blaze.

I hereby certify that the above described corner monument was properly established by me and witnessed by Jim DeMastus on April 23, 1985.

Witnessed: Jim DeMastus

**REGISTERED  
PROFESSIONAL  
LAND SURVEYOR**

*William L. Hanley*

**OREGON  
JULY 14, 1978  
WILLIAM L. HANLEY  
1639**

Office of County Surveyor..... County of Baker.....

State of Oregon..... I hereby certify that the within instrument was filed in this office

for record on the..... day of....., 19.....

..... by .....

(COUNTY OFFICIAL)

(DEPUTY)

FILED March 14, 1986  
BAKER COUNTY SURVEYOR  
SURVEY NO. 9-37-113