


**CERTIFIED RECORD OF LAND CORNER MONUMENTATION**

**History of original corner establishment:**

Corner established by Arthur Philbrick, U.S. Deputy Mineral Surveyor, under instructions received from the United States Surveyor General for Oregon, dated Nov.04, 1901 and designated as Survey No 452.

Surveyor General records state:  
No record of Discovery monument.

A tamarack 10 ins dia blazed and scribed B.T.B.B.-"Discovery"-452, bears N42°E 38.7 ft.

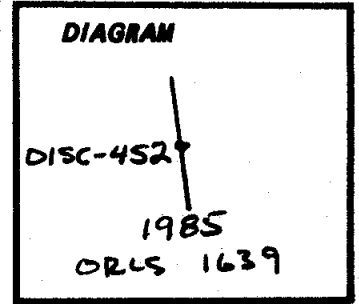

**Description of corner evidence found:**

A sawed tamarack stump and a separate long butt with scribes "DIS" visible on an open blaze, bears N42°E 38.7 ft.

**Description of monument and accessories established to perpetuate the original location of this corner:**

Set 2½ in aluminum cap on 2 in aluminum pipe 30 ins long 25 ins in ground with 5 ins proj. out of ground with rock mound and 6 ft steel fence post alongside with sign 54-9 attached.

Aluminum cap marked as shown in corner diagram.

**New bearing trees established:**

A tamarack 9 ins dia bears N08°45'W 12.9 ft marked DISCOVERY 452 BT.  
A fir 7 ins dia bears S32°W 24.0 ft marked DISCOVERY 452 BT.

Each original bearing tree and each new bearing tree has signs 54-3 and 54-9 attached below a 6 in band of red paint, additionally each new bearing tree has a brass washer marked PLS 1639 nailed flush with BT blaze.

I hereby certify that the above described corner monument was properly established by me and witnessed by Jim DeMastus on April 23, 1985.

Witnessed: Jim DeMastus

**REGISTERED  
PROFESSIONAL  
LAND SURVEYOR**

*William L. Hanley*

**OREGON  
JULY 14, 1978  
WILLIAM L. HANLEY  
1639**

Office of...County Surveyor..... County of...Baker.....

State of...Oregon....., I hereby certify that the within instrument was filed in this office

for record on the..... day of....., 19.....

..... by .....

(COUNTY OFFICIAL)

(DEPUTY)

FILED March 14, 1986  
BAKER COUNTY SURVEYOR  
SURVEY NO. 9-37-45 114-115