


CERTIFIED RECORD OF LAND CORNER MONUMENTATION

**History of original corner establishment:**

Corner established by Emil F. Voigt, U.S. Deputy Mineral Surveyor, under instructions received from the United States Surveyor for Oregon, dated July 27, 1892, and designated as Survey No. 257. Surveyor General records state:

Set a post 4½ ft long 4 ins square set 12 ins in ground with mound of stone marked Cor No 5 LCPC MS 257. A tamarack 8 ins dia bears N75°W 0.24 chs blazed and marked Cor No 5 LCPC MS 257 BT, a tamarack 30 ins dia bears N27°30'E 0.36 chs blazed and marked Cor No 5 LCPC MS 257 BT.

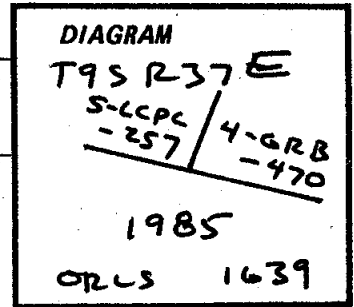

Corner established by John Hagel, U.S. Deputy Mineral Surveyor, under instructions received from United States General for Oregon, dated April 7, 1902, and designated as Survey No 470. Surveyor General records state: Found a pine post 5 ins square 3 ft above ground scribed LCPC 5 S 257 with mound of rocks around it. Set a black pine post 4 ins square 4½ ft long 18 ins in ground alongside old post scribed GRB 4-470, DPL 1-470. A black pine 8 ins dia bears S20°30'W 23.3 ft marked GRB 4-470 BT.

Corner position remonumented by John R. Mitchell in 1980...Set a 2½ ins brass cap on a 32"x 1" galv pipe in rock mound marked LCPC 5 MS 257. A douglas fir 10 ins dia bears N10°W 16 ft marked LCPC 5 MS 257 BT.

**Description of corner evidence found:**

Found monument set by John R. Mitchell.

- A tamarack 16 ins dia bears N75°W 24 lks with healed blaze.
- A lodgepole pine 10 ins dia bears S34°W 14.9 ft with scribes DPCC 1-470 BT.
- A ponderosa pine 17 ins dia bears S20°30'W 23.3 ft with healed blaze.
- A stump 30 ins dia bears N27°30'E 37 lks with no scribes visible.
- Tree found set by John R. Mitchell:
- A tamarack 7 ins dia bears S10°E 16 ft with scribes LCPC 5 MS 257 BT.

**Description of monument and accessories established to perpetuate the original location of this corner:**

Set a 2½" aluminum cap on 2" aluminum pipe 30 ins long 25 ins in ground with 5 ins proj. out of ground with surrounding rock mound and 6 ft steel fence post alongside with sign 54-9 attached. Buried monument alongside.

Aluminum cap marked as shown in corner diagram.

Each original bearing tree has signs 54-3 and 54-9 attached below a 6 inch band of red paint.

I hereby certify that the above described corner monument was properly established by me and witnessed by Jim DeMastus and Daryl Schuchardt on May 6, 1985.

Witnessed: Jim DeMastus

**REGISTERED  
PROFESSIONAL  
LAND SURVEYOR**

*William L. Hanley*

**OREGON  
JULY 14, 1978  
WILLIAM L. HANLEY  
1639**

Office of...County Surveyor..... County of...Baker.....  
Oregon  
State of....., I hereby certify that the within instrument was filed in this office  
for record on the..... day of....., 19.....

..... by .....  
(COUNTY OFFICIAL) (DEPUTY)

FILED March 14, 1986  
BAKER COUNTY SURVEYOR  
SURVEY NO. 9-37-117