

CERTIFIED RECORD OF LAND CORNER MONUMENTATION

History of original corner establishment:

Corner established by Emil R. Voigt, U.S. Deputy Mineral Surveyor, under instructions received from the United States Surveyor for Oregon, dated Survey No. 257.

Surveyor General records state:

Set a post 4 1/2 ft long 4 ins square set 12 ins in ground with mound of stone marked Cor No 6 LCPC MS NO 257.

A pine 8 ins dia bears N24°E 0.98 chs dist blazed and marked Cor No 6 LCPC MS NO 257 BT, a tamarack 11 ins dia bears N39°E 0.91 chs dist blazed and marked Cor No 6 LCPC MS No 257 BT.

Corner position remonumented by John R. Mitchell in 1980...Set a 2 1/2 ins brass cap on a 32"x 1" galv pipe in rock mound marked LCPC 6 MS 257.

A douglas fir 7 ins dia bears N40°E 30 ft dist, a lodgepole pine 6 ins dia bears N49°W 13 ft dist, both marked LCPC 6 MS 257 BT.

Description of corner evidence found:

Found monument set by John R. Mitchell.


A dead ponderosa pine 15 ins dia bears N24°E 98 lks.

A tamarack 12 ins dia bears N39°E 91 lks.

Trees found set by John R. Mitchell:

A dead lodgepole pine 6 ins dia bears N49°W 13 ft with scribes LCPC 6 MS 257 BT.

A douglas fir 8 ins dia bears N48°E (JRM record states N40°E) 30 ft.

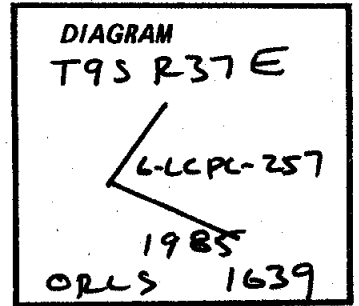

Description of monument and accessories | established to perpetuate the original location of this corner:

Set a 2 1/2" aluminum cap on 2" aluminum pipe 30 ins long 25 ins in ground with 5 ins proj. out of ground with surrounding rock mound and 6 ft steel fence post alongside with sign 54-9 attached. Buried monument alongside north.

Aluminum cap marked as shown in corner diagram.

New bearing tree established:

A lodgepole pine 7 ins dia bears S80°E 30.1 ft dist marked 6 LCPC-257 BT.

Each original bearing tree and each new bearing tree has signs 54-3 and 54-9 attached below a 6 in band of red paint, additionally each new bearing tree has a brass washer marked PLS 1639 nailed flush with BT blaze.

I hereby certify that the above described corner monument was properly established by me and witnessed by Jim DeMastus and Daryl Schuchardt on May 6, 1985.

Witnessed: Jim DeMastus

REGISTERED PROFESSIONAL LAND SURVEYOR

William L. Hanley

OREGON JULY 14, 1978 WILLIAM L. HANLEY 1639

Office of...County Surveyor..... County of... Baker

State of... Oregon....., I hereby certify that the within instrument was filed in this office

for record on the..... day of....., 19.....

..... by (COUNTY OFFICIAL) (DEPUTY)

FILED March 14, 1986

BAKER COUNTY SURVEYOR

SURVEY NO. 9-37-118