


CERTIFIED RECORD OF LAND CORNER MONUMENTATION

History of original corner establishment:

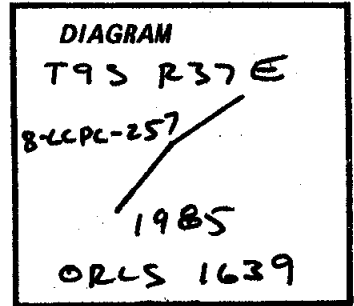

Corner established by Emil R. Voigt, U.S. Deputy Mineral Surveyor, under instructions received from the United States Surveyor for Oregon, dated Survey No. 257.

Surveyor General records state:

Set a post 4½ ft long 4 ins square 12 ins in ground with mound of stone marked Cor No 8 LCPC MS No 257.

A tamarack 18 ins dia bears N81°E 0.35 chs dist, a pine 28 ins dia bears S04°E 0.53 chs dist, both blazed and marked Cor No 8 LCPC MS 257 BT.

Corner position remonumented by John R. Mitchell in 1980...Set a 2½ ins brass cap on a 32"x 1" galv pipe in rock mound marked LCPC 8 MS 257.

A douglas fir 10 ins dia bears N67°E 6 ft, a white fir 9 ins dia bears S32°E 5 ft dist, both marked LCPC MS 257 BT.

Description of corner evidence found:

Found monument set by John R. Mitchell.

A tamarack 24 ins dia bears N81°E 35 lks with scribes visible.

A ponderosa pine 32 ins dia bears S04°E 53 lks with scribes visible on stump.

Trees found set by John R. Mitchell:

A douglas fir 10 ins dia bears N67°E 6 ft.

A white fir 9 ins dia bears S32°E 5 ft.

Description of monument and accessories | established to perpetuate the original location of this corner:

Set a 2½" aluminum cap on 2" aluminum pipe 30 ins long 25 ins in ground with 5 ins proj. out of ground with surrounding rock mound and 6 ft steel fence post alongside with sign 54-9 attached. Buried monument alongside north.

Aluminum cap marked as shown in corner diagram.

Each original bearing tree has signs 54-3 and 54-9 attached below a 6 inch band of red paint.

I hereby certify that the above described corner monument was properly established by me and witnessed by Jim DeMastus and Daryl Schuchardt on May 7, 1985.

Witnessed: Jim DeMastus

**REGISTERED  
PROFESSIONAL  
LAND SURVEYOR**

*William L. Hanley*

**OREGON  
JULY 14, 1978  
WILLIAM L. HANLEY  
1639**

Office of.....County Surveyor..... County of Baker.....  
State of Oregon....., I hereby certify that the within instrument was filed in this office  
for record on the..... day of....., 19.....

..... by .....  
(COUNTY OFFICIAL) (DEPUTY)

FILED March 14, 1986  
BAKER COUNTY SURVEYOR  
SURVEY NO. 9-37-119