

CERTIFIED RECORD OF LAND CORNER MONUMENTATION

History of original corner establishment:


Corner established by Emil R. Voigt, U.S. Deputy Mineral Surveyor, under instructions received from the United States Surveyor for Oregon, dated Survey No. 257.

Surveyor General records state:

Set a post 4 1/2 ft long 4 ins square 12 ins in ground with mound of stone marked Cor No 7 LCPC MS No 257.

A fir 11 ins dia bears S57°W 0.13 chs dist blazed and marked Cor No 7 LCPC MS No 257 BT, a tamarack 16 ins dia bears S60°E 0.28 chs dist blazed Cor No 7 LCPC MS No 257 BT.

Corner position remonumented by John R. Mitchell in 1980...Set a 2 1/2 ins brass cap on a 32"x 1" galv pipe in rock mound marked LCPC MS 257. A douglas fir 11 ins dia bears S61°E 7 ft marked LCPC 7 MS 257 BT.

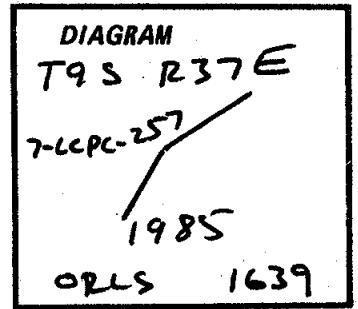

Description of corner evidence found:

Found monument set by John R. Mitchell.

A white fir 19 ins dia bears S57°W 19.8 ft with scribes visible. A tamarack 18 ins dia bears S60°E 18.5 ft with scribes visible. Tree found set by John R. Mitchell: A douglas fir 10 ins dia bears S61°E 7.0 ft.

Description of monument and accessories I established to perpetuate the original location of this corner:

Set a 2 1/2" aluminum cap on 2" aluminum pipe 30 ins long 25 ins in ground with 5 ins proj. out of ground with surrounding rock mound and 6 ft steel fence post alongside with sign 54-9 attached. Buried monument alongside north.

Aluminum cap marked as shown in corner diagram.

Each original bearing tree has signs 54-3 and 54-9 attached below a 6 inch band of red paint.

I hereby certify that the above described corner monument was properly established by me and witnessed by Jim DeMastus and Daryl Schuchardt on May 6, 1985.

Witnessed: Jim DeMastus

REGISTERED PROFESSIONAL LAND SURVEYOR

William L. Hanley

OREGON JULY 14, 1978 WILLIAM L. HANLEY 1639

Office of..... County Surveyor, County of Baker
State of Oregon..... I hereby certify that the within instrument was filed in this office
for record on the..... day of....., 19.....
..... by
(COUNTY OFFICIAL) (DEPUTY)

FILED March 14, 1986
BAKER COUNTY SURVEYOR
SURVEY NO. 9-37-119A