


CERTIFIED RECORD OF LAND CORNER MONUMENTATION

History of original corner establishment:

Corner established by John Hagel, U.S. Deputy Mineral Surveyor, under instructions received from United States Surveyor General for Oregon, dated April 7, 1902, and designated as Survey No. 470. Surveyor General records state:

Set a tamarack post 4 ins square 4½ ft long 18 ins in ground scribed BLB4-BRB1-GRB1-S 470 with a mound of rocks around it.  
A white fir 8 ins dia bears S69°W 3.2 ft dist marked BLB4-470 BT.  
A red fir 5 ins dia bears N77°W 15.3 ft dist marked GRB1-470 BT.

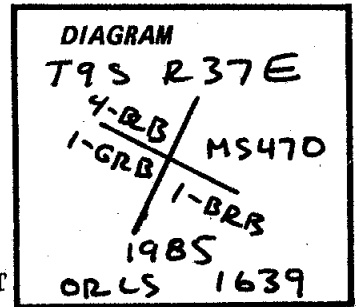

Corner position remonumented by John R. Mitchell in 1980...Set a 2½ ins brass cap on a 32"x 1" galv pipe in rock mound marked BR 1 MS 470.  
A tamarack 12 ins dia bears N46°W 21 ft.  
A white fir 10 ins dia bears N83°E 27 ft, both marked BR 1 MS 470 BT.

Description of corner evidence found:

Found monument set by John R. Mitchell.

A down portion of a douglas fir 10 ins dia bears N77°W 15.3 ft with fragmentary scribing.  
No evidence of other bearing tree.

Trees found by John R. Mitchell:  
A tamarack 12 ins dia bears N46°W 21 ft.  
A white fir 10 ins dia bears N83°E 27 ft.

Description of monument and accessories established to perpetuate the original location of this corner:

Set a 2½" aluminum cap on 2" aluminum pipe 30 ins long 25 ins in ground with 5 ins proj. out of ground with surrounding rock mound and 6 ft steel fence post alongside with sign 54-9 attached. Monument buried alongside north.

Aluminum cap marked as shown in corner diagram.

Each original bearing tree has signs 54-3 and 54-9 attached below a 6 inch band of red paint.

I hereby certify that the above described corner monument was properly established by me and witnessed by Jim DeMastus and Daryl Schuchardt on May 9, 1985.

Witnessed: Jim DeMastus

**REGISTERED  
PROFESSIONAL  
LAND SURVEYOR**

*William L. Hanley*

**OREGON  
JULY 14, 1978  
WILLIAM L. HANLEY  
1639**

Office of.....County...Surveyor..... County of.....Baker.....  
State of.....Oregon....., I hereby certify that the within instrument was filed in this office  
for record on the..... day of....., 19.....

..... by .....  
(COUNTY OFFICIAL) (DEPUTY)

FILED March 14, 1986  
BAKER COUNTY SURVEYOR  
SURVEY NO. 9-37-120