

CERTIFIED RECORD OF LAND CORNER MONUMENTATION

History of original corner establishment:


Corner established by John Hagel, U.S. Deputy Mineral Surveyor, under instructions received from United States Surveyor General for Oregon, dated April 7, 1902, and designated as Survey No. 470. Surveyor General records state:

Set a red fir post 4 ins square 4½ ft long 18 ins in the ground scribed GR.B.S.CEN.S.470.

A yellow pine tree 18 ins dia blazed and scribed GR.B.S.CEN.BT bears S85°45'E 7.4 ft.

Corner position remonumented by John R. Mitchell in 1980...Set 2½ in brass cap on 32"x1" gal pipe in rock mound marked GR.SEC MS 470 from which:

A douglas fir 13 ins dia bears S09°W 48 ft dist marked GR SEC MS 470 BT.

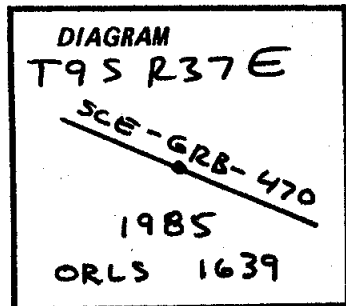

Description of corner evidence found:

Found brass cap set by John R. Mitchell.

A ponderosa pine 32 ins dia bears S86°E 7.5 ft with visible scribes.

A douglas fir 13 ins dia bears S09°W 48 ft set by John R. Mitchell.

Description of monument and accessories | established to perpetuate the original location of this corner:


Set a 2½" aluminum cap on 2" aluminum pipe 30 ins long 25 ins in ground with 5 ins proj. out of ground with surrounding rock mound and 6 ft steel fence post alongside with sign 54-9 attached. Buried monument alongside west.

Aluminum cap marked as shown in corner diagram.

Each original bearing tree has signs 54-3 and 54-9 attached below a 6 inch band of red paint.

I hereby certify that the above described corner monument was properly established by me and witnessed by Jim DeMastus and Daryl Schuchardt on May 7, 1985.

Witnessed: Jim DeMastus

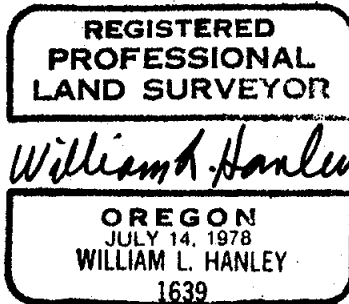

Office of...County..Surveyor..... County of..Baker.....  
State of.....Oregon....., I hereby certify that the within instrument was filed in this office  
for record on the..... day of....., 19.....

..... by .....  
(COUNTY OFFICIAL) (DEPUTY)

FILED March 14, 1986  
BAKER COUNTY SURVEYOR  
SURVEY NO. 9-37-121