

CERTIFIED RECORD OF LAND CORNER MONUMENTATION

History of original corner establishment:

Corner established by John Hagel, U.S. Deputy Mineral Surveyor, under instructions received from United States Surveyor General for Oregon, dated April 7, 1902, and designated as Survey No. 470. Surveyor General records state:


Set a yellow pine post 4 ins square 4 ft long 6 ins in ground to bedrock scribed BR B 3-GR B 5-S470 with mound of rocks around it.

A yellow pine tree 10 ins dia bears N11°35'E 22.4 mkd BR B 3-470 BT.

A yellow pine tree 10 ins dia bears S33°50'W 10.9 ft marked GR B 5-470 BT.

Corner position remonumented by John R. Mitchell in 1980...Set a 2½ ins brass cap on a 32"x 1" galv pipe in rock mound marked GR 5 MS 470 set 20 ins deep in original hole from which:

A douglas fir 9 ins dia bears N35°E 10 ft marked GR 5 MS 470 BT.

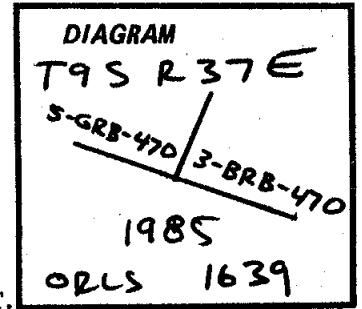

Description of corner evidence found:

Found monument set by John R. Mitchell.

A ponderosa pine stump 25 ins dia bears N11°35'E 22.4 ft no scribes visible.

A ponderosa 16 ins dia bears S33°50'W 10.9 ft with visible scribes.

A douglas fir 9 ins dia bears N35°E 10 ft set by John R. Mitchell.

Description of monument and accessories established to perpetuate the original location of this corner:

Set a 2½" aluminum cap on 2" aluminum pipe 30 ins long 25 ins in ground with 5 ins proj. out of ground with surrounding rock mound and 6 ft steel fence post alongside with sign 54-9 attached. Monument buried alongside north.

Aluminum cap marked as shown in corner diagram.

Each original bearing tree has signs 54-3 and 54-9 attached below a 6 inch band of red paint.

I hereby certify that the above described corner monument was properly established by me and witnessed by Jim DeMastus and Daryl Schuchardt on May 7, 1985.

Witnessed: Jim DeMastus

**REGISTERED
PROFESSIONAL
LAND SURVEYOR**

William L. Hanley

**OREGON
JULY 14, 1978
WILLIAM L. HANLEY
1639**

Office of.....County Surveyor..... County of..... Baker
Oregon
State of....., I hereby certify that the within instrument was filed in this office
for record on the..... day of....., 19.....

..... by
(COUNTY OFFICIAL) (DEPUTY)

FILED March 14, 1986
BAKER COUNTY SURVEYOR
SURVEY NO. 9-37-122