


CERTIFIED RECORD OF LAND CORNER MONUMENTATION

History of original corner establishment:

Corner established by John Hagel, U.S. Deputy Mineral Surveyor, under instructions received from United States Surveyor General for Oregon, dated April 7, 1902, and designated as Survey No. 470.

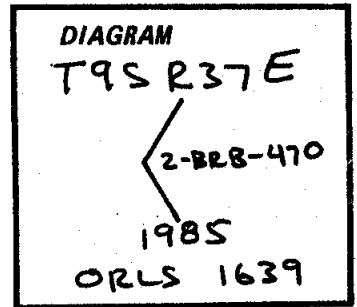

Surveyor General records state:

Set a yellow pine post 4 ins square 4 1/2 ft long 18 ins in ground with a mound of rocks around it scribed BRB 2-470-BRB 6-470.

A yellow pine 12 ins dia blazed and scribed BRB 2-470BT bears 71.22° 15' W 34.1 ft, a yellow pine 11 ins in diam blazed and scribed GRB 6-470 BT bears N44° 20' W 13.6 ft dist.

Description of corner evidence found:

Corner position is at top of cut of old logging road spur, no evidence of original post or bearing trees.

Description of monument and accessories I established to perpetuate the original location of this corner:

Set a 2 1/2" aluminum cap on 2" aluminum pipe 30 ins long 20 ins in ground with 11 ins proj. out of ground with surrounding rock mound and 6 ft steel fence post alongside with sign 54-9 attached.

Aluminum cap marked as shown in corner diagram.

New bearing trees established:

A fir 6 ins dia bears N01° W 12.6 ft dist marked 2 BRB 470 BT.

A fir 8 ins dia bears N83° E 21.5 ft dist marked 2 BRB 470 BT.

Each new bearing tree has signs 54-3 and 54-9 attached below a 6 inch band of red paint and has a brass washer marked PLS 1639 nailed flush with BT blaze.

I hereby certify that the above described corner monument was properly maintained to USFS standards under my supervision and witnessed by Jim DeMastus on May 14, 1985.

Witnessed: Jim DeMastus

REGISTERED
PROFESSIONAL
LAND SURVEYOR

William L. Hanley

OREGON
JULY 14, 1978
WILLIAM L. HANLEY
1639

Office of.....County..Surveyor..... County of..Baker.....

State of.....Oregon....., I hereby certify that the within instrument was filed in this office for record on the..... day of....., 19.....

..... by

(COUNTY OFFICIAL)

(DEPUTY)

FILED March 14, 1986

BAKER COUNTY SURVEYOR

SURVEY NO. 9-37-123