

CERTIFIED RECORD OF LAND CORNER MONUMENTATION

History of original corner establishment:


Corner established by John Hagel, U.S. Deputy Mineral Surveyor, under instructions received from United States Surveyor General for Oregon, dated April 7, 1902, and designated as Survey No. 470. Surveyor General records state:

Set a yellow pine post 4 ins square 4½ ft long 18 ins in ground scribed BR B S CEN S 470 with a mound of rocks around it.

Corner position remonumented by John R. Mitchell in 1980...Set a 2½ ins brass cap on a 32"x 1" galv pipe in rock mound marked BR SEC MS 470 set in original hole from which:

A douglas fir 14 ins dia bears S70°E 35 ft marked BR SEC MS 470 BT.

A ponderosa pine 8 ins dia bears S82°W 30 ft marked BR SEC MS 470 BT.

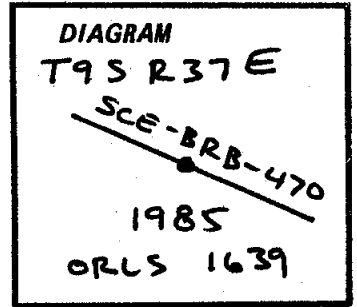

Description of corner evidence found:

Found monument set by John R. Mitchell.

A down ponderosa pine 22 ins dia bears S20°W 17.4 ft with visible scribes.

A douglas fir 14 ins dia bears S70°E 35 ft with full scribes.

A ponderosa pine 8 ins dia bears S82°W 30 ft with full scribes.

Description of monument and accessories | established to perpetuate the original location of this corner:

Set a 2½" aluminum cap on 2" aluminum pipe 30 ins long 25 ins in ground with 5 ins proj. out of ground with surrounding rock mound and 6 ft steel fence post alongside with sign 54-9 attached. Monument buried alongside north.

Aluminum cap marked as shown in corner diagram.

Each original bearing tree has signs 54-3 and 54-9 attached below a 6 inch band of red paint.

I hereby certify that the above described corner monument was properly established by me and witnessed by Jim DeMastus and Daryl Schuchardt on May 8, 1985.

Witnessed: Jim DeMastus

REGISTERED
PROFESSIONAL
LAND SURVEYOR

William L. Hanley

OREGON
JULY 14, 1978
WILLIAM L. HANLEY
1639

Office of... County Surveyor..... County of... Baker
Oregon
State of....., I hereby certify that the within instrument was filed in this office
for record on the..... day of....., 19.....

..... by
(COUNTY OFFICIAL) (DEPUTY)

FILED March 14, 1986
BAKER COUNTY SURVEYOR
SURVEY NO. 9-37-124