


CERTIFIED RECORD OF LAND CORNER MONUMENTATION

History of original corner establishment:

Corner established by John Hagel, U.S. Deputy Mineral Surveyor, under instructions received from United States Surveyor General for Oregon, dated April 7, 1902, and designated as Survey No. 470. Surveyor General records state:

Set a yellow pine post 4 ins square 4½ ft long 18 ins in ground scribed BRB N CENS470 with a mound of rocks around it.  
A yellow pine 12 ins dia blazed and scribed BRB N CEN S 470 BT bears S80°05'W 17.3 ft.

Corner position remonumented by John R. Mitchell in 1980...Set a 2½ ins brass cap on a 32"x 1" galv pipe in rock mound marked BRNECMS470.  
A white fir 8 ins dia bears S10°W 19 ft marked BRNECMS470 BT.

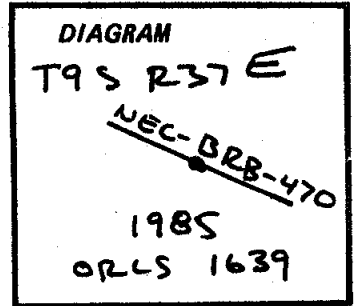

Description of corner evidence found:

Found monument set by John R. Mitchell.  
A ponderosa pine 20 ins dia bears S80°W 17.3 ft.  
Tree found set by John R. Mitchell:  
A white fir 8 ins dia bears S10°W 19 ft.

Description of monument and accessories I established to perpetuate the original location of this corner:

Set a 2½" aluminum cap on 2" aluminum pipe 30 ins long 25 ins in ground with 5 ins proj. out of ground with surrounding rock mound and 6 ft steel fence post alongside with sign 54-9 attached. Monument buried alongside north.

Aluminum cap marked as shown in corner diagram.

Each original bearing tree has signs 54-3 and 54-9 attached below a 6 inch band of red paint.

I hereby certify that the above described corner monument was properly established by me and witnessed by Jim DeMastus and Daryl Schuchardt on May 8, 1985.

Witnessed: Jim DeMastus

REGISTERED PROFESSIONAL LAND SURVEYOR

William L. Hanley

OREGON  
JULY 14, 1978  
WILLIAM L. HANLEY  
1639

Office of... County Surveyor..... County of... Baker.....  
State of... Oregon..... I hereby certify that the within instrument was filed in this office  
for record on the..... day of....., 19.....  
..... by .....  
(COUNTY OFFICIAL) (DEPUTY)

FILED March 14, 1988  
BAKER COUNTY SURVEYOR  
SURVEY NO. 9-37-128