


CERTIFIED RECORD OF LAND CORNER MONUMENTATION

History of original corner establishment:

Corner established by John Hagel, U.S. Deputy Mineral Surveyor, under instructions received from United States Surveyor General for Oregon, dated April 7, 1902, and designated as Survey No. 470. Surveyor General records state:

Set a white fir post 4 ins square 4½ ft long 18 ins in ground scribed BSB5-470 with a mound of rocks around it.
A yellow pine 40 ind dia blazed anr scribed BLB5-470 BT bears S28°E 31.4 ft.

Corner position remonumented by John R. Mitchell in 1980...Set a 2½ ins brass cap on a 32"x 1" galv pipe in rock mound marked BL 5 MS 470.
A white fir 9 ins dia bears N28°E 16 ft.
A douglas fir 11 ins dia bears N35°W 6 ft, both marked BL 5 MS 470 BT.

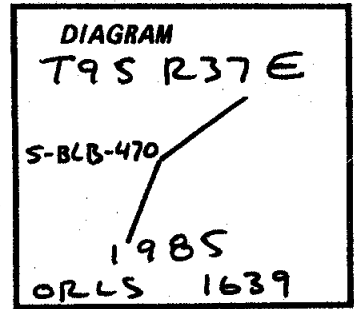

Description of corner evidence found:

Found monument set by John R. Mitchell.
A ponderosa pine 44 ins dia bears S28°E 31.9 ft.
Trees found set by John R. Mitchell:
A white fir 7 ins dia bears 28°E 16 ft.
A douglas fir 11 ins dia bears N35°W 6.5 ft.

Description of monument and accessories I established to perpetuate the original location of this corner:

Set a 2½" aluminum cap on 2" aluminum pipe 30 ins long 25 ins in ground with 5 ins proj. out of ground with surrounding rock mound and 6 ft steel fence post alongside with sign 54-9 attached. Monument buried alongside north.

Aluminum cap marked as shown in corner diagram.

Each original bearing tree has signs 54-3 and 54-9 attached below a 6 inch band of red paint.

I hereby certify that the above described corner monument was properly established by me and witnessed by Jim DeMastus and Daryl Schuchardt on May 9, 1985.

Witnessed: Jim DeMastus

**REGISTERED
PROFESSIONAL
LAND SURVEYOR**

William L. Hanley

**OREGON
JULY 14, 1978
WILLIAM L. HANLEY
1639**

Office of...County...Surveyor..... County of... Baker
State of... Oregon....., I hereby certify that the within instrument was filed in this office
for record on the..... day of....., 19.....
..... by
(COUNTY OFFICIAL) (DEPUTY)