

CERTIFIED RECORD OF LAND CORNER MONUMENTATION


History of original corner establishment:

Corner established by John Hagel, U.S. Deputy Mineral Surveyor, under instructions received from United States Surveyor General for Oregon, dated April 7, 1902, and designated as Survey No. 470. Surveyor General records state:

Set tamarack post 5 ins square 4½ ft long 18 ins in ground scribed BLB6-470 with a mound of rocks around it.

A white fir 21 ins dia bears N85°25'E 1.8 ft dist.

A white fir 17 ins dia bears S0°30'W 6.7 ft dist, both blazed and scribed BLB6-470 BT.

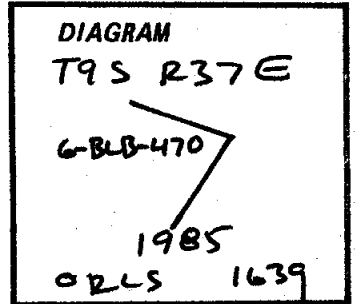

Corner position remonumented by John R. Mitchell in 1980...Set a 2½ ins brass cap on a 32"x 1" galv pipe in rock mound marked BL 6 MS 470.

A white fir 12 ins dia bears N68°W 14.5 ft dist.

A white fir 12 ins dia bears N37°E 2 ft dist, both marked BL 6 MS470 BT.

Description of corner evidence found:

Found monument set by John R. Mitchell.

A down white fir 20 ins dia bears S0°30'W 6.7 ft with full scribing.

Trees found set by John R. Mitchell:

A white fir 13 ins dia bears N68°W 14.5 ft with full scribes.

A white fir 13 ins dia bears N37°E 2 ft with full scribes.

Description of monument and accessories established to perpetuate the original location of this corner:

Set a 2½" aluminum cap on 2" aluminum pipe 30 ins long 25 ins in ground with 5 ins proj. out of ground with surrounding rock mound and 6 ft steel fence post alongside with sign 54-9 attached. Monument buried alongside north.

Aluminum cap marked as shown in corner diagram.

Each original bearing tree has signs 54-3 and 54-9 attached below a 6 inch band of red paint.

I hereby certify that the above described corner monument was properly established by me and witnessed by Jim DeMastus and Daryl Schuchardt on May 9, 1985.

Witnessed: Jim DeMastus

REGISTERED
PROFESSIONAL
LAND SURVEYOR

William L. Hanley

OREGON
JULY 14, 1978
WILLIAM L. HANLEY
1639

Office of...County Surveyor..... County of... Baker

State of... Oregon..... I hereby certify that the within instrument was filed in this office

for record on the..... day of....., 19.....

..... by

(COUNTY OFFICIAL)

(DEPUTY)

FILED March 14, 1985

BAKER COUNTY SURVEYOR

SURVEY NO. 9-37-130