


CERTIFIED RECORD OF LAND CORNER MONUMENTATION

History of original corner establishment:

None, corner established with this survey.

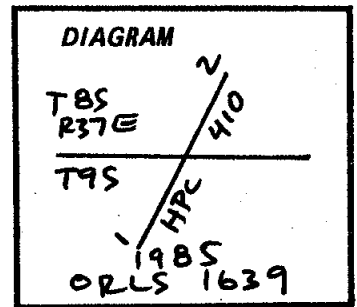

Description of corner evidence found:

None.

Description of monument and accessories established to perpetuate the original location of this corner:

Set a 2½" aluminum cap on 2" aluminum pipe 30 ins long 25 ins in ground with 5 ins proj. out of ground with surrounding rock mound and 6 ft steel fence post alongside with sign 54-9 attached.

Aluminum cap marked as shown in corner diagram.

New bearing trees established:

A fir 6 ins dia bears S35½°W 46.0 ft dist.

A fir 7 ins dia bears N47°E 34.6 ft dist, both trees marked 1 2 HPC 410/S 32 BT.

Each new bearing tree has signs 54-3 and 54-9 attached below a 6 inch band of red paint and has a brass washer marked PLS 1639 nailed flush with BT blaze.

I hereby certify that the above described corner monument was properly maintained to USFS standards under my supervision and witnessed by Jim DeMastus on May 17, 1985.

Witnessed: Jim DeMastus

**REGISTERED
PROFESSIONAL
LAND SURVEYOR**

William L. Hanley

**OREGON
JULY 14, 1978
WILLIAM L. HANLEY
1639**

Office of..... County Surveyor County of..... Baker

State of..... Oregon, I hereby certify that the within instrument was filed in this office for record on the..... day of....., 19.....

..... by

(COUNTY OFFICIAL)

(DEPUTY)

FILED March 14, 1986
BAKER COUNTY SURVEYOR
SURVEY NO. 9-37-133