


CERTIFIED RECORD OF LAND CORNER MONUMENTATION

History of original corner establishment:

None, corner established with this survey.

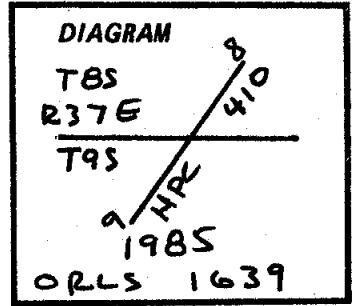

Description of corner evidence found:

None.

Description of monument and accessories | established to perpetuate the original location of this corner:

Set a 2½" aluminum cap on 2" aluminum pipe 30 ins long 25 ins in ground with 5 ins proj. out of ground with surrounding rock mound and 6 ft steel fence post alongside with sign 54-9 attached.

Aluminum cap marked as shown in corner diagram.

New bearing trees established:

A pine 11 ins dia bears S61°W 17.8 ft dist.

A fir 6 ins dia bears N24°W 12.0 ft dist, both trees marked 8 9 HPC 410/S 32 BT.

Each new bearing tree has signs 54-3 and 54-9 attached below a 6 inch band of red paint and has a brass washer marked PLS 1639 nailed flush with BT blaze.

I hereby certify that the above described corner monument was properly maintained to USFS standards under my supervision and witnessed by Jim DeMastus on May 17, 1985.

Witnessed: Jim DeMastus

**REGISTERED
PROFESSIONAL
LAND SURVEYOR**

William L. Hanley

**OREGON
JULY 14, 1978
WILLIAM L. HANLEY
1639**

Office of.....County Surveyor..... County of Baker
Oregon
State of....., I hereby certify that the within instrument was filed in this office
for record on the..... day of....., 19.....

..... by
(COUNTY OFFICIAL) (DEPUTY)

FILED March 14 - 1986
BAKER COUNTY SURVEYOR
SURVEY NO. 9-37-134