


CERTIFIED RECORD OF LAND CORNER MONUMENTATION

History of original corner establishment:

None, corner established with this survey.

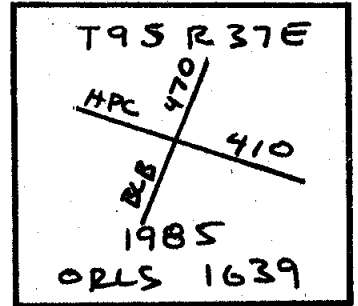

Description of corner evidence found:

None.

Description of monument and accessories I established to perpetuate the original location of this corner:

Set a 2½" aluminum cap on 2" aluminum pipe 30 ins long 25 ins in ground with 5 ins proj. out of ground with surrounding rock mound and 6 ft steel fence post alongside with sign 54-9 attached.

Aluminum cap marked as shown in corner diagram.

New bearing trees established:

A pine 8 ins dia bears S16½°W 64.3 ft dist .

A fir 8 ins dia bears S42°W 49.3 ft dist, both trees marked 9-1-HPC 410/S-6-BRB 470 BT.

Each new bearing tree has signs 54-3 and 54-9 attached below a 6 inch band of red paint and has a brass washer marked PLS 1639 nailed flush with BT blaze.

I hereby certify that the above described corner monument was properly maintained to USFS standards under my supervision and witnessed by Jim DeMastus on May 17, 1985.

Witnessed: Jim DeMastus

**REGISTERED  
PROFESSIONAL  
LAND SURVEYOR**

*William L. Hanley*

**OREGON  
JULY 14, 1978  
WILLIAM L. HANLEY  
1639**

Office of.....County..Surveyor..... County of..Baker.....

State of.....Oregon....., I hereby certify that the within instrument was filed in this office for record on the..... day of....., 19.....

..... by .....

(COUNTY OFFICIAL)

(DEPUTY)

FILED March 14, 1986  
BAKER COUNTY SURVEYOR  
SURVEY NO. 9-37-135