


CERTIFIED RECORD OF LAND CORNER MONUMENTATION

Corner No.2, Annululu Mill Site, M.S. No. 382 B

History of original corner establishment:

Corner **ORIGINALLY** established by C.M.Foster, U.S. Deputy Mineral Surveyor under instructions dated December 7, 1899, for mineral survey no. 382A & B.


Surveyor General records state: A pine post 4 ft long, 4 ins square set 18 ins in the ground, scribed 2-382-B whence: A tamarack 12 ins dia brs N3°W, 24 ft dist blazed and scribed 2-382-B, BT. A pine 8 ins dia brs S42°40'E, 21 ft dist blazed and scribed 2-382-B, BT.

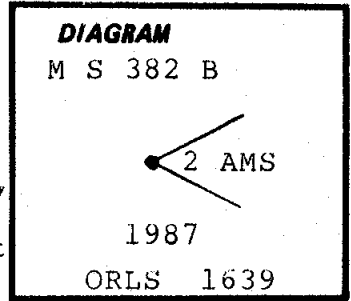

Corner **RECOVERED** and **PERPETUATED** by J.R.Mitchell, experienced corner recovery technician, as noted below. No record filed with Baker County Surveyor.

Description of corner evidence found:

Found a 2½" dia brass cap attached to a 1" dia galvanized iron pipe in rock mound from which: (brass cap mkd as shown to right) JRM-BT: A lodgepole pine 7" diam brs S76½°E, 38.4' dist mkd "2 382B BT" on a partially healed blaze. OBT: A green western larch 19" diam brs N01½°E, 23.7' dist with fully healed blaze(record, N3°W, 24') No trace of other OBT in old roadway(record, S42°40'E, 21').

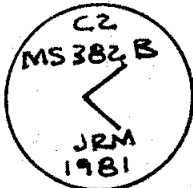

Description of monument and accessories established to perpetuate the original location of this corner:

At position of JRM brass cap monument which is the best available evidence of original corner position...

Removed brass cap monument and replaced with 2½" x 30" aluminum pipe with 2" aluminum cap 25" in ground surrounded with a mound of earth and stone. Set 6' steel fence post alongside with signs 54-2 and 54-9 attached. Cap marked as shown in corner diagram.

Recovered original and JRM BT's signed with signs 54-3 - no paint or signs 54-9 attached per landowner request.

Compass declination 20° East.

I hereby certify that the above corner monument was properly remonumented to U.S.F.S. standards by me and witnessed by Bill Gohring on October 7, 1987.

REGISTERED PROFESSIONAL LAND SURVEYOR

William L. Hanley

OREGON JULY 14, 1978 WILLIAM L. HANLEY 1639

Office of.....County Surveyor..... County of..... Baker
State of..... Oregon....., I hereby certify that the within instrument was filed in this office for record on the..... day of....., 19.....

..... by
(COUNTY OFFICIAL) (DEPUTY)

FILED 2-2-88
BAKER COUNTY SURVEYOR
SURVEY NO. 9-37-140