

CERTIFIED RECORD OF LAND CORNER MONUMENTATION


Corner No.3, Annululu Mill Site, M.S. 382 B

History of original corner establishment:

Corner ORIGINALLY established by C.M.Foster, U.S. Deputy Mineral Surveyor under instructions dated December 7, 1899., for mineral survey no. 382A & B.

Surveyor General records state: A pine post 4' long, 4" square, set 18" in ground scribed 3-382-B whence: A pine 8" dia brs N36°W, 8' dist blazed and scribed 3-382-B BT.

A pine 8" dia brs S58°30'W, 12.5' dist, blazed and scribed 3-382B BT.

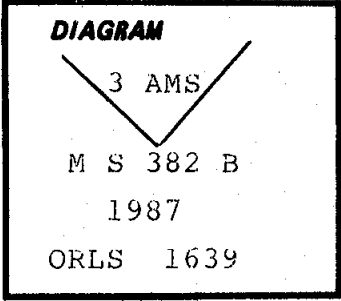

Corner RECOVERED and PERPETUATED by J.R.Mitchell, experienced corner recovery technician, as noted below. No record filed with Baker County Surveyor.

Description of corner evidence found:

No trace of original pine post.


Found a 2" dia brass cap attached to a 1" dia galvanized iron pipe in rock mound from which: (brass cap mkd as shown to right)

OBT: A sawed lodgepole pine stump 14" dia brs S58°30'W, 12.5' per record with small piece of lower blaze inside 3" overgrowth and 5' long butt alongside mkd ANNULULU MILLSITE MS 382 COR 3 BT. No trace of other OBT.

JRM-BT: A lodgepole pine 10" dia brs N69°W, 19.9' dist mkd 3-382B BT.

A lodgepole pine 8" dia brs N24°W, 32.5' dist mkd 3-382B BT.

Both JRM-BT's have a partially healed blaze.

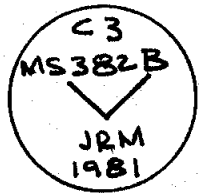

Description of monument and accessories I established to perpetuate the original location of this corner:

At position of JRM brass cap monument which is the best available evidence of original corner position...

Removed brass cap monument & replaced with 2 1/2" x 30" aluminum pipe with 2 1/2" aluminum cap 20" in ground surrounded with a mound of earth and stone. Set 6' steel fence post alongside with signs 54-2 & 54-9.

Painted 6" band of red paint around each OBE & JRM-BT, also painted blaze red and attached signs 54-3 & 54-9. Cap marked as shown in corner diagram. Compass declination 20° East.

I hereby certify that the above corner monument was properly remonumented to U.S.F.S. standards by me and witnessed by Bill Gohring on October 7, 1987.

REGISTERED PROFESSIONAL LAND SURVEYOR

William L. Hanley

OREGON JULY 14, 1978 WILLIAM L. HANLEY 1639

Office of..... County Surveyor..... County of..... Baker
State of..... Oregon..... I hereby certify that the within instrument was filed in this office for record on the..... day of....., 19.....

..... by
(COUNTY OFFICIAL) (DEPUTY)

FILED 2-2-88
BAKER COUNTY SURVEYOR
9-37-141