


**CERTIFIED RECORD OF LAND CORNER MONUMENTATION**

Corner No.4, Annululu Mill Site, M.S. 382 B

**History of original corner establishment:**

Corner ORIGINALLY established by C.M.Foster, U.S. Deputy Mineral Surveyor under instructions dated December 7, 1899, for mineral survey no. 382A & B.

Surveyor General records state: A pine post 4 ft long 4 ins square set 18 ins in the ground scribed 4-382-B whence: A fir 14 ins dia brs N55°W, 16 ft dist blazed and scribed 4-382-B, BT. A fir 8 ins dia brs S69°W, 12.5 ft dist blazed and scribed 4-382-B, BT.

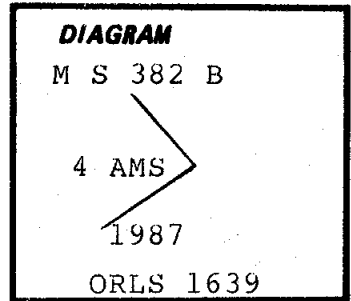


Corner RECOVERED and PERPETUATED by J.R.Mitchell, experienced corner recovery technician, as noted below. No record filed with Baker County Surveyor.

**Description of corner evidence found:**

No trace of original pine post.

Found a 2½" dia brass cap attached to a 1" dia galvanized iron pipe in rock mound from which; (brass cap mkd as shown to right)

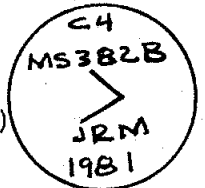

OBT's: A green white fir 16" dia brs S69°W, 12.5' dist with fully healed blaze.

A sawed fir stump 14" dia brs N55°W, 16.0' dist with small axe mark on remaining stump which has F.S. blue cut paint at root crown.

JRM-BT: A white fir 7" dia brs N86½°W, 23.6' dist mkd 3 382B BT on partially healed blaze.

**Description of monument and accessories I established to perpetuate the original location of this corner:**

At position of JRM brass cap monument which is the best available evidence of original corner position...

Removed brass cap monument & replaced with 2½" x 30" aluminum pipe with 2" aluminum cap 20" in ground surrounded with a mound of earth and stone. Set 6' steel fence post alongside with signs 54-2 & 54-9. Painted 6" band of red around each OBT & JRM-BT, also painted blaze red, and attached signs 54-3 & 54-9. Cap marked as shown in corner diagram. Compass declination 20° East.

I hereby certify that the above corner monument was properly remonumented to U.S.F.S. standards by me and witnessed by Bill Gohring on October 7, 1987.

REGISTERED  
PROFESSIONAL  
LAND SURVEYOR

*William L. Hanley*

OREGON  
JULY 14, 1978  
WILLIAM L. HANLEY  
1639

Office of..... County Surveyor..... County of..... Baker  
State of..... Oregon..... I hereby certify that the within instrument was filed in this office  
for record on the..... day of....., 19.....

..... by .....  
(COUNTY OFFICIAL) (DEPUTY)