


**CERTIFIED RECORD OF LAND CORNER MONUMENTATION**


History of original corner establishment: Corner originally ESTABLISHED by John Hagel, U.S. Deputy Mineral Surveyor, under instructions dated June 30, 1902, for the Amazon Group of Quartz Claims, MS No. 480. Surveyor General records state: To Cor. No. 2 Brooklyn Lode, identical with the SW cor of the location. Identical with Cor No 1 of the "Amazon" Lode of this survey. Set a tamarack post 5 ins square 4½ ft long 18 ins in ground scribed BRO C 2 AMA C 1 SUR 480 with a mound of earth around it. A black pine tree 6 ins diam blazed and scribed BRO C 2 480 BT brs S80°45'E, 12.3 ft. A black pine tree 8 ins diam blazed and scribed AMA C 1-480 BT brs N55°E, 6.7 ft.

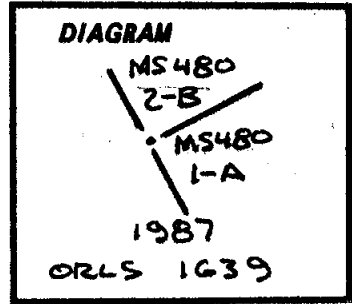

Corner REESTABLISHED by L.L. Myers, ORLS 699, in 1970 as described in his record filed with the Baker County Surveyor (No. 9-37-16) on Aug. 31, 1977, which states: (Found) "None, apparent lost to logging activity about 1945" (Established) "Using the west-end center post location the BT being a 12" spruce that brs S49°W, 9.8' which is not monumented, and Mineral Survey No. 447 Rainbow Lode Corner 5, the location of this corner was reestablished. Set a 5/8"x3" rebar with 2" aluminum cap, mkd as shown (above) for the corner. (See below for actual marking)

**Description of corner evidence found:**

No trace of original tamarack post or original accessory BTs. Found a 5/8" x 30" rebar with 1½" diam aluminum cap per record of Baker County Survey Nos. 9-37-16 & 9-37-15 and marked as shown to right.

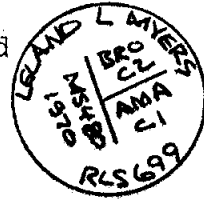

**Description of monument and accessories established to perpetuate the original location of this corner:**

At position of rebar with 1½" aluminum cap...

Removed rebar and replaced with 2"x30" aluminum pipe with 2½" aluminum cap 25" in ground and surrounded with a mound of earth and stone. Cap marked as shown in corner diagram. Set 6" steel fence post alongside with signs 54-2 & 54-9 attached. Drove rebar below ground surface alongside aluminum cap.

**New bearing trees established:**

A spruce 11" dia brs S48½°W, 17.0' dist mkd B-2-A-1-480 BT.  
 A lodgepole pine 6" dia brs S85°W, 26.0' dist mkd B-2-A-1-480 BT.

New bearing trees have a brass washer marked PLS 1639 nailed to face of blaze. Attached signs 54-3 & 54-9 and painted face of blaze and 6" band of red paint around each BT.

Compass declination 20° East.

I hereby certify that the above corner monument was properly REMONUMENTED to U.S.F.S. standards by me and witnessed by Bill Gohring on December 07, 1987.

**REGISTERED  
PROFESSIONAL  
LAND SURVEYOR**

*William L. Hanley*

**OREGON  
JULY 14, 1978  
WILLIAM L. HANLEY  
1639**

Office of.....County Surveyor..... County of...Baker.....  
 State of.....Oregon....., I hereby certify that the within instrument was filed in this office  
 for record on the..... day of....., 19.....

..... by .....

(COUNTY OFFICIAL)

(DEPUTY)

FILED 2-18-88  
 BAKER COUNTY SURVEYOR  
 SURVEY NO. 9-37-145